LAND CORNER RECORDATION CERTIFICATE
Filing Requirement of Act 74, Mich. P.A. 1970 as Amended

For corners in

Iron (County)

	Located In:	Corner Code #
1. Public Land Survey	T 45N R 34W	K3
	T 45N R 34W	MC East of I1
	T ___ R ___	
	S___ T___ R___	
2. Property Controlling	S___ T___ R___	
in Section	S___ T___ R___	
3. Miscellaneous	S___ T___ R___	
Property in Sec.	S___ T___ R___	

Register of Deeds Stamp & File Number

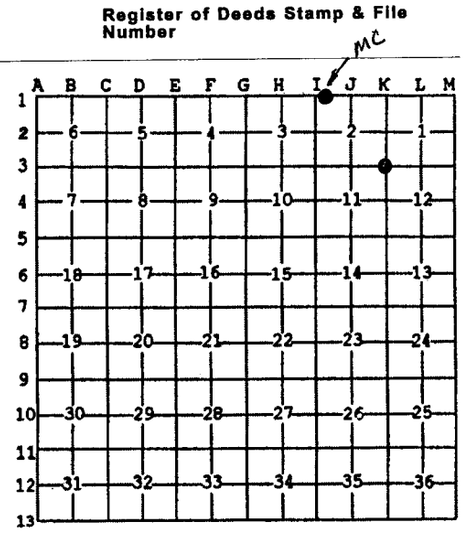

4. Lot No. _____ , Recorded Plat_____

5. Private Claims

MC May 17 2007
K3 May 24 2007

I, Stephan J. Szyszkoski, in a field survey on _____, 20 ____ do hereby state that under requirements of P.A. 74, Michigan P.A. of 1970, the corner points mentioned in lines 1 and 2 above were in conformance with regulations and rules therefore as required in the current manual of survey instructions of the United States Department of the Interior, Bureau of Land Management or by a decree of a Court of Law and /or that the corner points mentioned in lines 3, 4 and 5 above were in conformance with the rules of the Michigan Board of Land Surveyors or by a Decree of a Court of Law; established, re-established, monumented, recovered, found as expressed below:

NOTE: Not more than 2 corners, all in the same town and range, may be recorded on this certificate.

A. Description of original monument and accessories and/or subsequent restoration:

(K3) Corner common to Sections 1-2-11-12. 1965 - Reestablished by Neal Sperhake RLS as recorded in Liber 2 Page 424, Iron County Land Corner Records. Mr. Sperhake placed a Witness Corner 15 feet south of the corner position. 1"x36" iron pipe with Kimberly-Clark Corp. aluminum cap. Aspen 4" S37W 31.5 links, Aspen 6" N16E 87 links, Spruce 9" N43W 77 links, Balsam 12" S28E 65.5' links.
(MC East of I1) Meander corner on the Township line at the east bank of the Net River between Section 2 T45N-R34W and Section 35 T46N-R34W. 1846 - Established by Wm. A. Burt, Deputy Surveyor: West on South side Sec. 35 ...76.30 Intersected Lake or River C SSW. Set meander post. Cedar 14 S73E 36 links, B.Ash 6 N65E 68 links. Found no subsequent record.

B. Description of corner evidence found and/or method applied in restoring or reestablishing corner:

(K3) Recovered the witness corner monument as recorded. Monumented the corner proper, which falls in the center of a road, 15.00' north of the 1965 WC and on a line between the WC and monumented corner K2.
(MC east of I1) The original post and accessories were not recovered. The position for the corner falls in the Net River. Reestablished the corner on the Township line between corners H1 and K1 and at index-corrected record GLO distance west of K1 (76.30 ch. GLO, 5040.97' M). Placed a Witness Corner to the MC on the Township line 126.25' East of the reestablished position, being 52' east of the water's edge.

C. Description of monument for corner and accessories established to perpetuate locating the position of the corner:

(K3) Set 5/8"x17" rebar w/plastic cap stamped "MICH DNR PS33986" 4" below surface. Set measuring nails in:
4" Cherry N10W 32.35' mrkd "S2 NBT"
6" Spruce N25E 34.55' "S1 NBT"
7" R.Pine S55E 23.65' "S12 NBT"
6" Spruce S44W 28.15' "S11 NBT"
Sperhake's mon. of record S03W 15.00'
Bearings are magnetic. Distances are to nail with MDNR tag.

(MC) Set 1"IDx32" I.pipe with 4" alum. MDNR cap for a Witness Corner, 126.25' East of the position for the Meander Corner. Set measuring nails in:
8" Ash N56E 44.9' mrkd "WC BT"
3" Elm S61E 33.6' do
2" Ash S29W 20.7' do
14" Ash S89W 39.2' do
Set sq'd cedar post adjacent. Bearings are magnetic. Distances are to nails with tag.

STATE OF MICHIGAN
STEPHAN J. SZYSZKOSKI
LAND SURVEYOR
No. 33986
LICENSED LAND SURVEYOR

Signed by Stephan J. Szyszkoski Date 5/31/07

Surveyor's Michigan License No. 33986

For the Michigan Department of Natural Resources, Office of Land and Facilities

FORM APPROVED BY MICHIGAN STATE BOARD OF PROFESSIONAL SURVEYORS, JAN. 28, 1971
Revised May 14, 1975
Revised Jan., 1983
Rervised Oct., 1995