LAND CORNER RECORDATION CERTIFICATE
Filing Requirement of Act 74, Mich. P.A. 1970 as Amended

For corners in

Iron (County)

	Located In:			Corner Code #
1. Public Land Survey		T____	R____	
		T____	R____	
		T____	R____	
	S____	T____	R____	
2. Property Controlling	S 2	T 45N	R 34W	4
in Section	S 2	T 45N	R 34W	SMC west of #8
3. Miscellaneous	S____	T____	R____	
Property in Sec.	S____	T____	R____	

Register of Deeds Stamp & File Number

4. Lot No. _____ , Recorded Plat_____

5. Private Claims

SMC May 10 2007
4 May 14 2007

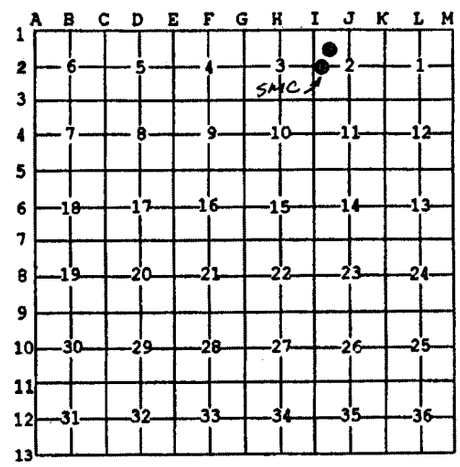

I, Stephan J. Szyszkoski, in a field survey on _____, 20____ do hereby state that under requirements of P.A. 74, Michigan P.A. of 1970, the corner points mentioned in lines 1 and 2 above were in conformance with regulations and rules therefore as required in the current manual of survey instructions of the United States Department of the Interior, Bureau of Land Management or by a decree of a Court of Law and /or that the corner points mentioned in lines 3, 4 and 5 above were in conformance with the rules of the Michigan Board of Land Surveyors or by a Decree of a Court of Law; established, re-established, monumented, recovered, found as expressed below:

NOTE: Not more than 2 corners, all in the same town and range, may be recorded on this certificate.

A. Description of original monument and accessories and/or subsequent restoration:

(4-Sec. 2) Northwest 1/16 corner, Section 2. Not established in the original survey.
(SMC west of 1/16 corner #8, Sec. 2) Special Meander Corner on the E-W 1/4 line of Sec. 2 at the East bank of the Net River. Not established in the original survey.

B. Description of corner evidence found and/or method applied in restoring or reestablishing corner:

(4-Sec. 2) Established the corner at the intersection of 1/16 lines. The N-S 1/16 line is a line through 1/16 corner #15 whose bearing is the mean of the N-S 1/4 line and the West line of the Section. The E-W 1/16 line is parallel to the E-W 1/4 line and parallel to a line between Section corners I3 and K3.
(SMC west of 1/16 corner #8, Sec. 2) Established the corner on the east bank of the Net River at its intersection with the E-W 1/4 line of Section 2. The E-W 1/4 line is a line through corner K2 parallel to the Section line between corners I3-K3.

C. Description of monument for corner and accessories established to perpetuate locating the position of the corner:

(4) Set 1"IDx32" I.pipe with 4" alum. MDNR cap. Set measuring nails in:
11" Sugar S56E 32.7 mrkd "1/16S BT"
8" Sugar in clump N64E 44.2' do
10" Sugar S26W 43.7' do
7" Sugar N68W 41.5' do
Set sq'd balsam post adjacent. Bearings are magnetic. Distances are to nail with tag.

(SMC) Set 1"IDx32" I.pipe with 4" alum. MDNR cap. Set measuring nails in:
8" Maple North 5.7' mrkd "SMC BT"
9" Sugar S80E 7.8' do
8" Balsam S66W 30.1' do
8" Spruce N30W 36.6' do
Set sq'd Maple post adjacent. Bearings are magnetic. Distances are to nail with MDNR tag.

STATE OF MICHIGAN
STEPHAN J. SZYSZKOSKI
LAND SURVEYOR
No. 33986
LICENSED LAND SURVEYOR

Signed by Stephan J. Szyszkoski Date 5/31/07

Surveyor's Michigan License No. 33986

For the Michigan Department of Natural Resources, Office of Land and Facilities

FORM APPROVED BY MICHIGAN STATE BOARD OF PROFESSIONAL SURVEYORS, JAN. 28, 1971
Revised May 14, 1975
Revised Jan., 1983
Rervised Oct., 1995