

**SURVEY & REMONUMENTATION**

JAN 19 1999

**SECTION**

**LAND CORNER RECORDATION CERTIFICATE**  
Filing Requirement of Act 74, Mich. P.A. 1970

For corners in

<u>Iron</u> (County)	Located In:	Corner Code #
1. Public Land Survey	T <u>44N</u> R <u>36W</u>	<u>M-1</u>
	T <u>44N</u> R <u>35W</u>	<u>A-1</u>
	T <u>45N</u> R <u>36W</u>	<u>M-13</u>
	T <u>45N</u> R <u>35W</u>	<u>A-13</u> ✓
2. Property Controlling in Section	S ___ T ___ R ___	___
	S ___ T ___ R ___	___
3. Miscellaneous Property in Sec.	S ___ T ___ R ___	___
	S ___ T ___ R ___	___

IRON COUNTY  
MICHIGAN  
RECEIVED FOR RECORD  
98 DEC 28 AM 11:20  
*L.C. Records: L. 7, P. 288*  
*[Signature]*  
Register of Deeds Stamp & File Number

4. Lot No. \_\_\_\_\_, Recorded Plat \_\_\_\_\_  
5. Private Claims \_\_\_\_\_

Section Corner Section 36, T45N, R36W, Section 31, T45N, R35W  
Section Corner Section 1, T44N, R36W, Section 6, T44N, R35W

I, Gary L. Pisoni, in a field survey on Nov. 18, 1998 do hereby state that under requirements of P.A. 74, Michigan P.A. of 1970, the corner points mentioned in lines 1 and 2 above were in conformance with regulations and rules therefore as required in the current manual of survey instructions of the United States Department of the Interior, Bureau of Land Management or by a decree of a Court of Law and /or that the corner points mentioned in lines 3, 4 and 5 above were in conformance with the rules of the Michigan Board of Land Surveyors or by a Decree of a Court of Law; established, re-established, monumented, recovered, found as expressed below:

1	A	B	C	D	E	F	G	H	I	J	K	L	M
2		6		5		4		3		2		1	
3													
4		7		8		9		10		11		12	
5													
6		18		17		16		15		14		13	
7													
8		19		20		21		22		23		24	
9													
10		30		29		28		27		26		25	
11													
12		31		32		33		34		35		36	
13													

NOTE: Not more than 2 corners, all in the same town and range, may be recorded on this certificate.

A. Description of original monument and accessories and/or subsequent restoration:

Original corner established on September 16, 1846 by William A. Burt, U.S. Deputy Surveyor.  
Original Corner; Wood Post  
Original Bearing Trees:

White Pine	24"	S 39° E	70 links (46.20 feet)
Spruce	8"	N 37° W	41 links (27.06 feet)

On 11/30/85, Gary L. Pisoni, RLS restored the corner position by double proportionate measurement methods from the quarter corner between Sections 32 and 5; Section corner between Sections 34, 35, 3 and 2; Section corner between Sections 25, 30, 36 and 31 (T45N, R35-36W); Section corner between Sections 12, 7, 13 and 18 (T44N, R35-36W). Corner position is marked by a 2 1/2" diameter by 30" long aluminum pipe monument, 6" below roadbed surface with a 3" aluminum cap stamped as follows: T45N, R36W, R35W, S-36, S-31, S-1, S-6, T44N, 1985, RLS 27457. Recorded in L.C. certificate Liber 5, Page 267 on 3/21/86.

1985 Bearing Trees:

Jack Pine	8"	N 1°W	37.45 feet
Jack Pine	8"	S 23°W	52.91 feet
Jack Pine	8"	N 51°W	41.05 feet
R.M.		South	24.72 feet
Steel sign post		South	27.50 feet

PEER GROUP APPROVED  
[Signature]  
COUNTY REPRESENTATIVE

B. Description of corner evidence found and/or method applied in restoring or reestablishing corner:

No evidence of original B.T.s found. Found monument as described above and the following bearing trees:


Jack Pine	9"	N 1°W	37.44 feet
Jack Pine	9"	S 23°W	52.92 feet
Jack Pine	10"	N 51°W	41.09 feet
R.M.		South	24.72 feet
Steel sign post		South	27.5 feet

I accept the above monument as the best available evidence for restoring the corner position.

Corner record research on file with County Representative.

C. Description of monument for corner and accessories established to perpetuate locating the position of the corner:

98-131  
Signed by [Signature] Date 12-21-98  
Surveyor's Michigan License No. 27457

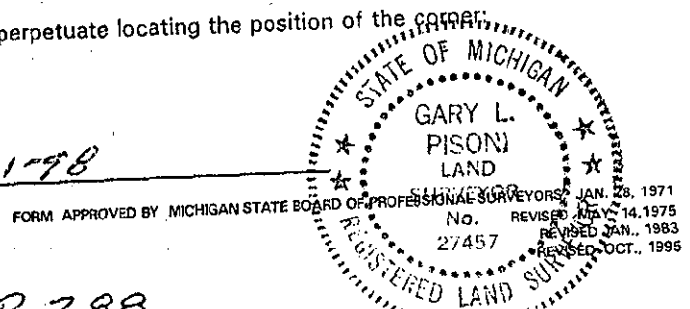

L. 7 P. 288