

SURVEY & REMONUMENTATION

JAN 19 1999

SECTION

LAND CORNER RECORDATION CERTIFICATE
Filing Requirement of Act 74, Mich. P.A. 1970

For corners in

<u>Iron</u> (County)	Located In:	Corner Code #
1. Public Land Survey	T <u>45N</u> R <u>35W</u>	<u>I-2</u>
	T _____ R _____	_____
	T _____ R _____	_____
	T _____ R _____	_____
2. Property Controlling in Section	S _____ T _____ R _____	_____
	S _____ T _____ R _____	_____
3. Miscellaneous Property in Sec.	S _____ T _____ R _____	_____
	S _____ T _____ R _____	_____

IRON COUNTY MICHIGAN
RECEIVED FOR RECORD

98 DEC 28 AM 11:14
L.C. Records: L. 7, P. 256

Richard Stebbins

Register of Deeds Stamp & File Number

4. Lot No. _____, Recorded Plat _____
5. Private Claims _____

Quarter Corner Sections 2 and 3, T45N, R35W

I, Gary L. Pisoni, in a field survey on November 2, 1998 do hereby state that under requirements of P.A. 74, Michigan P.A. of 1970, the corner points mentioned in lines 1 and 2 above were in conformance with regulations and rules therefore as required in the current manual of survey instructions of the United States Department of the Interior, Bureau of Land Management or by a decree of a Court of Law and /or that the corner points mentioned in lines 3, 4 and 5 above were in conformance with the rules of the Michigan Board of Land Surveyors or by a Decree of a Court of Law; established, re-established, monumented, recovered, found as expressed below:

	A	B	C	D	E	F	G	H	I	J	K	L	M
1													
2		6		5		4		3	●	2		1	
3													
4		7		8		9		10		11		12	
5													
6		18		17		16		15		14		13	
7													
8		19		20		21		22		23		24	
9													
10		30		29		28		27		26		25	
11													
12		31		32		33		34		35		36	
13													

NOTE: Not more than 2 corners, all in the same town and range, may be recorded on this certificate.

A. Description of original monument and accessories and/or subsequent restoration:

Original corner established in 1851 by Harvey Mellen, U.S. Deputy Surveyor.
Original Corner; Wood Post
Original Bearing Trees:
Spruce 3" N 16° E 24 links (15.84 feet)
Spruce 6" S 33° E 36 links (23.76 feet)

On 2-15-66, Donald D. Lappala, RLS U.S.F.S., restored the corner position at record bearing and distance from the stump remains of the two original bearing trees. He set a 2" diameter by 5' long galvanized iron pipe with a 3" brass cap stamped as follows: T45N, R35W, 1/4, S-2, S-3, RLS 12585, 1966, 18" above ground surface, recorded in L.C. Certificate Liber 3, Page 76.

1966 Bearing Trees:
Tamarack 4" N 44° E 29.1 feet
Tamarack 3" S 55° E 9.8 feet
White Pine 4" S 34° W 59.2 feet

B. Description of corner evidence found and/or method applied in restoring or reestablishing corner:

No evidence of original B.T.s found.

Found monument set by Donald D. Lappala in 1966 and the following bearing trees:
Tamarack 3" N 47° E 28.99 feet
White Pine 3" S 35° W 59.18 feet

PEER GROUP APPROVED
Iron County Rep 11-24-98
COUNTY REPRESENTATIVE

Corner record research on file with County Representative.

C. Description of monument for corner and accessories established to perpetuate locating the position of the corner:


Blazed and scribed the following bearing trees: (All measurements taken to a nail in side of tree)

Black Spruce 3" S 52° E 14.00 feet
Black Spruce 3" N 86° W 6.57 feet
Steel sign post South 0.70 feet

98-129
Signed by Gary L. Pisoni
Surveyor's Michigan License No. 27457

Date 12-21-98

FORM APPROVED BY MICHIGAN STATE BOARD OF PROFESSIONAL SURVEYORS
JAN. 28, 1971
REVISED MAY 14, 1975
REVISED JAN., 1983
REVISED OCT., 1995

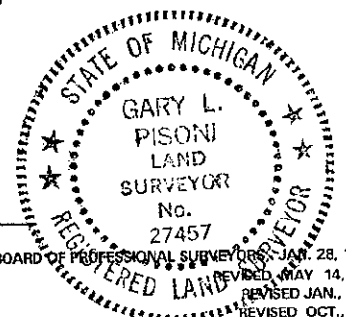

L. 7 P. 256