

SURVEY & REMONUMENTATION

FORM NO. 985-A



MAR 19 1997

Stock No. 26273

COMMISSION

LAND CORNER RECORDATION CERTIFICATE Filing Requirement of Act 74, Mich. P.A. 1970

For corners in

Iron
(County)

Located In:

Corner Code #

1. Public Land Survey

T 46N R 35W	L-13
T 45N R 35W	L-13
T _____ R _____	_____
T _____ R _____	_____

2. Property Controlling in Section

S _____ T _____	R _____	_____
S _____ T _____	R _____	_____

3. Miscellaneous Property in Sec.

S _____ T _____	R _____	_____
S _____ T _____	R _____	_____

IRON COUNTY
MICHIGAN
RECEIVED FOR RECORD

96 DEC 23 AM 8:51

L.C. Records L.7, P.24

Gary L. Pisoni
REGISTERED LAND SURVEYOR

Register of Deeds Stamp & File Number

4. Lot No. _____, Recorded Plat _____

5. Private Claims _____

Quarter Corner 36, T46N R35W
1, T45N R35W

I, Gary L. Pisoni, in a field survey on October 10, 1996 do hereby state that under requirements of P.A. 74, Michigan P.A. of 1970, the corner points mentioned in lines 1 and 2 above were in conformance with regulations and rules therefore as required in the current manual of survey instructions of the United States Department of the Interior, Bureau of Land Management or by a decree of a Court of Law and /or that the corner points mentioned in lines 3, 4 and 5 above were in conformance with the rules of the Michigan Board of Land Surveyors or by a Decree of a Court of Law; established, re-established, monumented, recovered, found as expressed below:

NOTE: Not more than 2 corners, all in the same town and range, may be recorded on this certificate.

A	B	C	D	E	F	G	H	I	J	K	L	M
1												
2	6	5		4		3		2		1		
3												
4	7	8		9		10		11		12		
5												
6	18	17		16		15		14		13		
7												
8	19	20		21		22		23		24		
9												
10	30	29		28		27		26		25		
11												
12	31	32		33		34		35		36		
13												

A. Description of original monument and accessories and/or subsequent restoration:

Original corner established by William Burt, U.S. Deputy Surveyor on September 19, 1846.

Original corner: Yellow Birch Post

Original bearing trees:

Lynn	12"	N 57°E	33 links (21.78 feet)
Sugar	10"	N 02°W	22 links (14.52 feet)

B. Description of corner evidence found and/or method applied in restoring or reestablishing corner:

No original corner evidence found. Corner restored by single proportionate measurement methods on line between the Northeast and Northwest Section corners of Section 1, T45N R35W.


Corner Record Research on file with County Representative.

PEER GROUP APPROVED
Gary L. Pisoni 12-11-96
COUNTY REPRESENTATIVE

C. Description of monument for corner and accessories established to perpetuate locating the position of the corner:

At the corner position, I set a 2" diameter by 30" long split base aluminum pipe monument with a 3" cast aluminum cap, stamped to read: Iron County Remonumentation, T46N, R35W, 1/4, S-36, S-1, T45N, 1996, RLS - 27457 from which I established the following new blazed and scribed bearing trees: (all measurements taken to a nail in side of tree)

Sugar Maple	9"	N 13° W	14.20 feet
Ironwood	8"	N 31° E	31.73 feet
Sugar Maple	9"	S 74° E	37.25 feet
Sugar Maple	6"	S 60° W	9.71 feet
Steel Sign Post	6"	N 10° W	0.81 feet

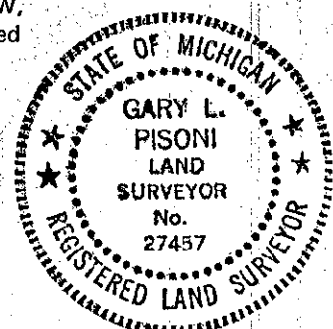

#96-02
Signed by *Gary L. Pisoni*

Date 12-10-96

Surveyor's Michigan License No. 27457

L.7 P.24