

LAND CORNER RECORDATION CERTIFICATE
Filing Requirement of Act 74, Mich. P.A. 1970 as Amended

For corners in

<u>Iron</u> (County)	Located In:	Corner Code #	
1. Public Land Survey	T46N R 31W	L11	
	T46N R 31W	K10	
	T ___ R ___		
2. Property Controlling in Section	S ___ T ___ R ___		
	S ___ T ___ R ___		
3. Miscellaneous Property in Sec.	S ___ T ___ R ___		
	S ___ T ___ R ___		
4. Lot No. _____, Recorded Plat _____			
5. Private Claims			

Register of Deeds Stamp & File Number

A	B	C	D	E	F	G	H	I	J	K	L	M
1												
2	6		5		4		3		2		1	
3												
4	7		8		9		10		11		12	
5												
6	18		17		16		15		14		13	
7												
8	19		20		21		22		23		24	
9												
10	30		29		28		27		26	●	25	
11											●	
12	31		32		33		34		35		36	
13												

I, Stephan J. Szyszkoski, in a field survey on Feb 28, 2008, do hereby state that under requirements of P.A. 74, Michigan P.A. of 1970, the corner points mentioned in lines 1 and 2 above were in conformance with regulations and rules therefore as required in the current manual of survey instructions of the United States Department of the Interior, Bureau of Land Management or by a decree of a Court of Law and /or that the corner points mentioned in lines 3, 4 and 5 above were in conformance with the rules of the Michigan Board of Land Surveyors or by a Decree of a Court of Law; established, re-established, monumented, recovered, found as expressed below:

NOTE: Not more than 2 corners, all in the same town and range, may be recorded on this certificate.

A. Description of original monument and accessories and/or subsequent restoration:

(L11) Quarter corner common to Sections 25 and 36. 1986 - Reestablished by single proportionate measurement to the original record, midway and on the Section line between K11 and M11, by K.L.Sackett RLS. Set 1"IDx36" iron pipe with MDNR plastic cap # 19006. 7" Balsam S84E 13.9', 6" Spruce N74W 16.3', 8" Spruce N56E 40.2'.

(K10) Quarter corner common to Sections 25 and 26. 1986 - Reestablished by single proportionate measurement to the original record, midway and on the Section line between K9 and K11, by K.L.Sackett RLS. Set 1"IDx36" I.pipe with plastic cap # 19006. 9" Spruce N14W 11.4', 6" Balsam S84W 22.4', 4" Spruce SE 23.8'.

B. Description of corner evidence found and/or method applied in restoring or reestablishing corner:

(L11) Recovered the 1986 monument in good condition, at the record position, and at record bearing and distance from the 1986 witnesses, now all dead and down. Accepted the monument as a careful and faithful reestablishment of the position of the original corner.


(K10) Recovered the 1986 monument, in good condition, and at the record position between Section corners. The 1986 witnesses were not recovered and must be dead and down under the snow. Accepted the monument as a careful and faithful reestablishment of the position of the original corner.

C. Description of monument for corner and accessories established to perpetuate locating the position of the corner:

(L11) Found 1"ID I.pipe with plastic cap # 19006
 Set measuring nail with MDNR tag in the side of:
 7" Spruce N13E 10.3' mrkd "1/4S NBT"
 7" Balsam S59E 18.5' do
 5" Spruce N44W 21.0' do
 4" Spruce N08W 25.5' do
 Sq'd cedar post adjacent. Bearings magnetic.

(K10) Found 1"ID I.pipe with plastic cap # 19006.
 Set measuring nail with MDNR tag in the side of:
 3" Poplar N21E 17.2' mrkd "1/4S NBT"
 7" Poplar S77E 7.5' do
 14" W.Pine S30W 31.2' do
 2" Tamarack N81W 26.7' do
 Sq'd cedar post adjacent. Bearings magnetic.

Signed by Stephan J. Szyszkoski

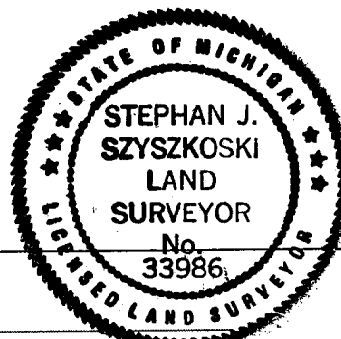

Date 3/5/08

Surveyor's Michigan License No. 33986