

**LAND CORNER RECORDATION CERTIFICATE**


Authority: 1970 PA 74, MCL 54.205

Surveyor's Name: Stephan J. Szyszkoski

Field Survey Date: September 1, 2016

For corner(s) in: Iron County

Original Public Land Survey Corner		Corner Code
a. S _____	T 46N R 32W	E05 (GCDB 300500)
b. S _____	T 46N R 32W	E09 (GCDB 300300)
S _____	T _____ R _____	_____
S _____	T _____ R _____	_____
Property Corner		1/16 Corner Code
S _____	T _____ R _____	_____
S _____	T _____ R _____	_____
S _____	T _____ R _____	_____
S _____	T _____ R _____	_____

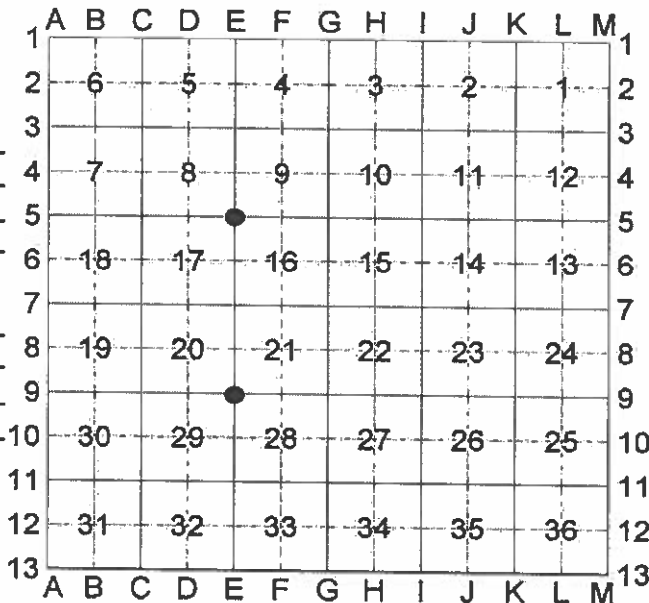

**Part A. Corner History**

a.) Corner common to Sections 8-9-16-17. 1852 - Established by Francis Houck, U.S. Deputy, monument presumed to be a post. Y. Birch 12" N19°W 41 links, W.Pine 16" S35°E 54 links. Northern Paper Mills records: 1931 - B.G.Buell and Ellison found Y.Bir. N.W. and W.Pine stump. I.M. plain. 1953 - S.Wickman and H.Gerry found Y.Bir. I.M. plain & rotting pine stump. Set pipe with brass cap. New B.T. Spruce 10" S28°E 18 links.

b.) Corner common to Sections 20-21-28-29. 1852 - Established by Francis Houck, U.S. Deputy, monument presumed to be a post. Y.Birch 14" N29°W 40 links, Sugar 8" S26°E 12 links. Found no subsequent record.

**Part B: Surveyor's Report on Perpetuation, Restoration, Reestablishment, or Monumentation of Corner**

a.) Found the 1953 monument in good condition with 3 nearby trees marked with large blazes facing the monument. The 1953 witness Spruce was not found. Accepted the monument as a careful and faithful perpetuation of the position of the original corner.

b.) The original post and accessories were not recovered. Found no evidence of the position of the original corner on the ground. Reestablished the position for the corner by double proportionate measurement to the original record between corners E05 10538.13' (159.82 ch. R) north; G09 5234.71' (79.36 ch. R) east; E13 10526.23' (159.64 ch. R) south; and D09 2624.48' (39.79 ch. R) west.

**Part C: Field Evidence of Perpetuation or Monumentation of Corner**

a.) Found 1"ID I.pipe with 2" brass N.P.M. cap. Set measuring nail with MDNR tag in the side of:  
 8" Spruce N28°E 10.9' mrkd "S9 NBT"  
 5" Balsam S49°E 15.55' "S16 NBT"  
 7" Spruce S79°W 17.4' "S17 NBT"  
 7" Spruce N58°W 8.65' "S8 NBT"  
 E= 7898062.256 N= 179546.638

b.) Set 1"IDx28" I.pipe with 2" alum. MDNR cap. Set measuring nail with MDNR tag in the side of:  
 5" Sugar S84°E 16.95' mrkd "S28 NBT"  
 7" Sugar S19°E 27.95' "S28 NBT"  
 12" Sugar S15°W 22.3' "S29 NBT"  
 11" Sugar S56°W 26.5' "S29 NBT"  
 Set sq'd cedar post adjacent. The corner falls in a woods road. The monument is set flush with the ground.  
 E= 7898006.669 N= 176335.657

Bearings are magnetic. Coordinates are MCS83, NAD83(2011) Epoch 2010.00, in meter  
 Coordinate Reference: MDNR Network control "BONE", a 1"ID I.pipe with 2" alum cap., E= 7899059.778 m. N= 176329.657 m.

Stephan J. Szyszkoski 10/13/2016

