



# SURVEY & REMONUMENTATION

Stock No. 26273

MAR 19 1997

## COMMISSION LAND CORNER RECORDATION CERTIFICATE

Filing Requirement of Act 74, Mich. P.A. 1970

For corners in

_____ Iron _____ (County)	Located In:	Corner Code #
1. Public Land Survey	T <u>46N</u> R <u>34W</u>	<u>E-9</u>
	T _____ R _____	_____
	T _____ R _____	_____
	T _____ R _____	_____
2. Property Controlling in Section	S _____ T _____ R _____	_____
	S _____ T _____ R _____	_____
3. Miscellaneous Property in Sec.	S _____ T _____ R _____	_____
	S _____ T _____ R _____	_____

IRON COUNTY MICHIGAN RECEIVED FOR RECORD

96 DEC 23 AM 9:03  
L.C. Records L. 7, P. 46  
*Gary L. Pisoni*  
REGISTERED LAND SURVEYOR

Register of Deeds Stamp & File Number

4. Lot No. \_\_\_\_\_, Recorded Plat \_\_\_\_\_  
5. Private Claims \_\_\_\_\_

Section Corner 20, 21, 28 & 29, T46N R34W

Gary L. Pisoni, in a field survey on October 22, 19 96 do hereby state that under requirements of P.A. 74, Michigan P.A. of 1970, the corner points mentioned in lines 1 and 2 above were in conformance with regulations and rules therefore as required in the current manual of survey instructions of the United States Department of the Interior, Bureau of Land Management or by a decree of a Court of Law and/or that the corner points mentioned in lines 3, 4 and 5 above were in conformance with the rules of the Michigan Board of Land Surveyors or by a Decree of a Court of Law; established, re-established, monumented, recovered, found as expressed below:

NOTE: Not more than 2 corners, all in the same town and range, may be recorded on this certificate.

1. Description of original monument and accessories and/or subsequent restoration:

Original corner established by Z.B. Searls, U.S. Deputy Surveyor on July 9, 1852.

Original corner: Wood Post  
Original bearing trees:

White Pine	20"	S 35° W	24 Links (15.84feet)
Cedar	12"	N 45° E	27 Links (17.82feet)

On August 16, 1951, Dean C. LaMater, R.L.S., set a 1" dia. iron pipe with a 4" brass Department of Conservation Forestry Division cap from evidence of original bearing tree. Recorded in Land Corner Certificate L.2, Page 8 on August 10, 1976.

1951 bearing trees:

Yellow Birch	8"	N 22° E	37 links (24.42 feet)
Cedar	4"	S 07° E	35 links (23.10 feet)

2. Description of corner evidence found and/or method applied in restoring or reestablishing corner:

Found the monument and fallen cedar bearing tree as described above as well as wood post next to corner. Said monument was found in two pieces due to acid soil rotting pipe.

Corner Record Research on file with County Representative.


Description of monument for corner and accessories established to perpetuate locating the position of the corner:

At the corner position, I replaced broken monument and set a 3/4" outside diameter by 3 feet long aluminum rod monument with a 3" cast aluminum cap, stamped to read: Iron County Remonumentation, T46N, R34W, S-20, S-21, S-29, S-28, 1996, RLS - 27457 from which I established the following new blazed and scribed bearing trees: (all measurements taken to a nail in side of tree)

Balsam	8"	N 10° E	38.30 feet
Black Spruce	8"	N 37° E	48.77 feet
Black Spruce	7"	S 46° W	8.75 feet
Cedar	14"	N 27° W	49.68 feet
Steel Sign Post	6'	S 20° E	0.84 feet

	A	B	C	D	E	F	G	H	I	J	K	L	M
1													
2	6		5		4		3		2		1		
3													
4	7		8		9		10		11		12		
5													
6	18		17		16		15		14		13		
7													
8	19		20		21		22		23		24		
9													
10	30		29		28		27		26		25		
11													
12	31		32		33		34		35		36		
13													

PEER GROUP APPROVED  
*Iron Gary L. Pisoni 12-11-96*  
COUNTY REPRESENTATIVE

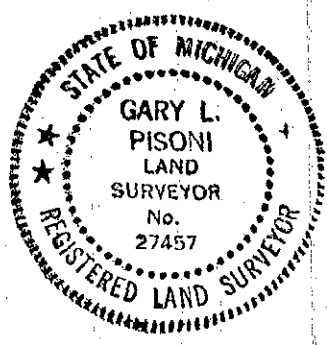

36-24 signed by Gary L. Pisoni Date 12-10-96  
Surveyor's Michigan License No. 27457

L. 7 P. 46