

SURVEY & REMONUMENTATION

JAN 19 1999

SECTION

LAND CORNER RECORDATION CERTIFICATE
Filing Requirement of Act 74, Mich. P.A. 1970

For corners in

<u>Iron</u> (County)	Located In:	Corner Code #
1. Public Land Survey	T <u>46N</u> R <u>34W</u>	<u>E-11</u>
	T _____ R _____	_____
	T _____ R _____	_____
	T _____ R _____	_____
2. Property Controlling in Section	S _____ T _____ R _____	_____
	S _____ T _____ R _____	_____
3. Miscellaneous Property in Sec.	S _____ T _____ R _____	_____
	S _____ T _____ R _____	_____

IRON COUNTY MICHIGAN
 RECEIVED FOR RECORD

98 DEC 28 AM 11:28
 L.C. Records: L. 7, P. 329

Gary L. Pisoni
 REGISTERED LAND SURVEYOR

Register of Deeds Stamp & File Number

4. Lot No. _____, Recorded Plat _____
 5. Private Claims _____

Section Corner Sections 28, 29, 32 and 33 T46N R34W

I, Gary L. Pisoni, in a field survey on June 1, 19 98 do hereby state that under requirements of P.A. 74, Michigan P.A. of 1970, the corner points mentioned in lines 1 and 2 above were in conformance with regulations and rules therefore as required in the current manual of survey instructions of the United States Department of the Interior, Bureau of Land Management or by a decree of a Court of Law and /or that the corner points mentioned in lines 3, 4 and 5 above were in conformance with the rules of the Michigan Board of Land Surveyors or by a Decree of a Court of Law; established, re-established, monumented, recovered, found as expressed below:

A	B	C	D	E	F	G	H	I	J	K	L	M
1												
2	6		5		4		3		2		1	
3												
4	7		8		9		10		11		12	
5												
6	18		17		16		15		14		13	
7												
8	19		20		21		22		23		24	
9												
10	30		29		28		27		26		25	
11												
12	31		32		33		34		35		36	
13												

NOTE: Not more than 2 corners, all in the same town and range, may be recorded on this certificate.

A. Description of original monument and accessories and/or subsequent restoration:

Original corner established by Z.B. Searls, U.S. Deputy Surveyor on July 9, 1852.

Original corner: Wood Post
 Original bearing trees:

Yellow Birch	10"	S 17° E	7 Links (4.62 feet)
Yellow Birch	10"	N 48° W	35 Links (23.10 feet)

PEER GROUP APPROVED
Gary L. Pisoni 12-18-98
 COUNTY REPRESENTATIVE

B. Description of corner evidence found and/or method applied in restoring or reestablishing corner:

Corner restored from the recovered original bearing trees. One is a 24" Yellow Birch stump, N 48° W, 23.10 feet; second one is a large stump hole which bears S 17° E, 4.6 feet.

Corner Record Research on file with County Representative.

C. Description of monument for corner and accessories established to perpetuate locating the position of the corner:

At the corner position, set a 3/4" diameter aluminum rod monument, 3 feet long with a 3" diameter aluminum cap stamped as follows: Iron County Remonumentation, T46N, R34W, S-28, S-29, S-32, S-33, 1998, RLS 27457 from which I established the following new blazed and scribed bearing trees: (All measurements taken to a nail in side of tree)


Sugar Maple	14"	N 09° E	39.58 feet
Sugar Maple	8"	S 42° E	4.19 feet
Sugar Maple	8"	S 50° W	24.10 feet
Sugar Maple	10"	S 87° W	13.24 feet
Steel sign post		East	0.6 feet

#98-157

Signed by *Gary L. Pisoni*
 Surveyor's Michigan License No. 27457

Date 12-21-98

FORM APPROVED BY MICHIGAN STATE BOARD OF PROFESSIONAL SURVEYORS, JAN. 28, 1971
 NO. REVISED MAY 24, 1975
 27457 REVISED JAN. 1983
 REVISED OCT. 1995

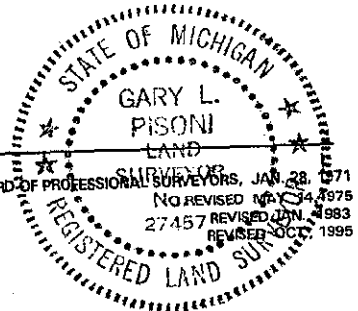

L. 7 P. 329