

**LAND CORNER RECORDATION CERTIFICATE**  
**Filing Requirement of Act 74, Mich. P.A. 1970 as Amended**

For corners in

<u>Iron</u> (County)	Located In:	Corner Code #
1. Public Land Survey	T46N R 34W	K8
	T46N R 34W	M3
	T R	
	S T R	
2. Property Controlling in Section	S T R	
	S T R	
3. Miscellaneous Property in Sec.	S T R	
	S T R	

Register of Deeds Stamp & File Number

4. Lot No. \_\_\_\_\_, Recorded Plat \_\_\_\_\_  
 5. Private Claims

M3 May 30 2007  
 K8 May 24 2007

I, Stephan J. Szyszkoski, in a field survey on \_\_\_\_\_, 20\_\_ do hereby state that under requirements of P.A. 74, Michigan P.A. of 1970, the corner points mentioned in lines 1 and 2 above were in conformance with regulations and rules therefore as required in the current manual of survey instructions of the United States Department of the Interior, Bureau of Land Management or by a decree of a Court of Law and /or that the corner points mentioned in lines 3, 4 and 5 above were in conformance with the rules of the Michigan Board of Land Surveyors or by a Decree of a Court of Law; established, re-established, monumented, recovered, found as expressed below:

1	A	B	C	D	E	F	G	H	I	J	K	L	M
2		6		5		4		3		2		1	
3													
4		7		8		9		10		11		12	
5													
6		18		17		16		15		14		13	
7													
8		19		20		21		22		23		24	
9													
10		30		29		28		27		26		25	
11													
12		31		32		33		34		35		36	
13													

**NOTE: Not more than 2 corners, all in the same town and range, may be recorded on this certificate.**

**A. Description of original monument and accessories and/or subsequent restoration:**

(K8) Quarter corner common to Sections 23-24. 1852 - Established by Z.B. Searls, Deputy Surveyor, midway and on the section line between Section corners 40.19 chains south and 40.18 chains north. Set post. Fir 4 S41W 4 links, Cedar 18 N80E 16 links. Found no subsequent record.

(M3) Corner common to Sections 1-12 T46N-R34W and Sections 6-7 T46N-R33W. 1846 - Established by Austin Burt, Deputy Surveyor: Set cedar post. W. Birch 8 S35W 6 links, Cedar 11 N70E 20 links. Found no subsequent record.

**B. Description of corner evidence found and/or method applied in restoring or reestablishing corner:**

(K8) The original post and accessories were not recovered. Found a 3/4" ID iron pipe, projecting 2.9', loosely set in a mound of rock. The position of the pipe is in substantial accord with the original record bearing and distance to recorded corner 2641.72' north and recorded corner on the township line 13203.03' south. I accept same as the best available evidence of the position of the original corner.


(M3) The original post and accessories were not recovered. Found no evidence of the position of the original corner on the ground. Reestablished the corner by single proportionate measurement to the original record and on line between Township corner 5186.65' north (GLO record = 78.62 chains) and Quarter corner 7916.53' south (GLO record = 120 chains).

**C. Description of monument for corner and accessories established to perpetuate locating the position of the corner:**

(K8) Set 1"IDx32" I.pipe with 4" alum. MDNR cap driven to refusal (8") and made firm with a mound of rock. Set a measuring nail with MDNR tag in:  
 5" Sugar N58E 22.5' mrkd "1/4S NBT"  
 17" Spruce East 31.2' do  
 13" Cedar S01E 44.5' do  
 13" Spruce N85W 42.8' do  
 Set sq'd spruce post adjacent. Bearings are magnetic. Distances are to nail in side of tree.

(M3) Set 1"IDx32" I.pipe with 4" alum. MDNR cap. Set a measuring nail with MDNR tag in:  
 17" W.Spruce N18E 22.0' mrkd "S6 NBT"  
 15" Cedar S60W 36.5' "S12 NBT"  
 6" Tamarack N51W 46.6' "S1 NBT"  
 16" double Tamarack N09W 27.3' "S1 NBT"  
 Bearings are magnetic. Distances are to nail with tag in the side of the tree.

Signed by Stephan J. Szyszkoski

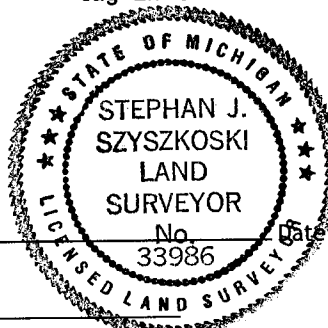

Surveyor's Michigan License No. 33986

Date 11/6/07