

LAND CORNER RECORDATION CERTIFICATE
Filing Requirement of Act 74, Mich. P.A. 1970 as Amended

For corners in

<u>Iron</u> (County)	Located In:	Corner Code #
1. Public Land Survey	<u>T46N R 34W</u>	<u>L9</u>
	<u>T R</u>	<u> </u>
	<u>T R</u>	<u> </u>
2. Property Controlling in Section	<u>S 24 T46N R 34W</u>	<u>8</u>
	<u>S T R</u>	<u> </u>
	<u>S T R</u>	<u> </u>
3. Miscellaneous Property in Sec.	<u>S T R</u>	<u> </u>
	<u>S T R</u>	<u> </u>

Register of Deeds Stamp & File
Number

4. Lot No. _____, Recorded Plat _____
 5. Private Claims

I, Stephan J. Szyszkoski, in a field survey on Jun 05, 2007 do hereby state that under requirements of P.A. 74, Michigan P.A. of 1970, the corner points mentioned in lines 1 and 2 above were in conformance with regulations and rules therefore as required in the current manual of survey instructions of the United States Department of the Interior, Bureau of Land Management or by a decree of a Court of Law and /or that the corner points mentioned in lines 3, 4 and 5 above were in conformance with the rules of the Michigan Board of Land Surveyors or by a Decree of a Court of Law; established, re-established, monumented, recovered, found as expressed below:

1	A	B	C	D	E	F	G	H	I	J	K	L	M
2		6		5		4		3		2		1	
3													
4		7		8		9		10		11		12	
5													
6		18		17		16		15		14		13	
7													
8		19		20		21		22		23		24	
9													
10		30		29		28		27		26		25	
11													
12		31		32		33		34		35		36	
13													

NOTE: Not more than 2 corners, all in the same town and range, may be recorded on this certificate.

A. Description of original monument and accessories and/or subsequent restoration:

(L9) Quarter corner common to Sections 24-25. 1852 - Established by Z.B.Searls, Deputy Surveyor, midway and on the Section line between Section corners 40.10 chains east and west. Set post. Y.Birch 4 S40E 9 links, Spruce 10 N39W 23 links. Found no subsequent record.

(8-Sec. 24) West 1/16 corner, Section 24. Not established in the original survey. Found no subsequent record.

B. Description of corner evidence found and/or method applied in restoring or reestablishing corner:


(L9) The original post and accessories were not recovered. Found no evidence of the position of the original corner on the ground. Reestablished the corner by single proportionate measurement to the original record, midway and on the Section line between Section corners 2635.54' east and west.

(8-Sec. 24) Established the corner midway and on a straight line between Quarter corner 1313.98' west and Center of Section 1313.98' east.

C. Description of monument for corner and accessories established to perpetuate locating the position of the corner:

(L9) Set 1"IDx32" I.pipe with 4" alum. MDNR cap.	(8) Set 1"IDx32" I.pipe with 4" alum. MDNR cap.
Set a measuring nail with MDNR tag in:	Set measuring nail with MDNR tag in:
13" Cedar N17W 19.9' mrkd "1/4S NBT"	12" Cedar S30E 16.3' mrkd "1/16S BT"
7" Tamarack S81E 39.55' do	12" Cedar S08W 24.75' do
10" Maple N83W 9.25' do	5" B.Ash N76W 13.2' do
8" Spruce N46W 24.4' do	3" B.Ash N03W 16.5' do
Set sq'd spruce post adjacent. Brgs. are magnetic.	Set sq'd cedar post adjacent. Brgs. are magnetic.
Distances are to nail with tag in the side of tree.	Dist. are to nail with tag in the side of tree.

Signed by Stephan J. Szyszkoski

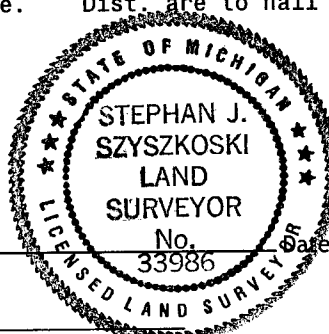

Surveyor's Michigan License No. 33986

11/6/07