

LAND CORNER RECORDATION CERTIFICATE
Filing Requirement of Act 74, Mich. P.A. 1970 as Amended

For corners in

<u>Iron</u> (County)	Located In:	Corner Code #
1. Public Land Survey	T <u>46N</u> R <u>34W</u>	<u>M5</u>
	T ___ R ___	_____
	T ___ R ___	_____
2. Property Controlling in Section	S <u>24</u> T <u>46N</u> R <u>34W</u>	<u>1</u>
	S ___ T ___ R ___	_____
	S ___ T ___ R ___	_____
3. Miscellaneous Property in Sec.	S ___ T ___ R ___	_____
	S ___ T ___ R ___	_____

4. Lot No. _____, Recorded Plat _____
 5. Private Claims

I, Stephan J. Szyszkoski, in a field survey on Jun 05, 2007 do hereby state that under requirements of P.A. 74, Michigan P.A. of 1970, the corner points mentioned in lines 1 and 2 above were in conformance with regulations and rules therefore as required in the current manual of survey instructions of the United States Department of the Interior, Bureau of Land Management or by a decree of a Court of Law and /or that the corner points mentioned in lines 3, 4 and 5 above were in conformance with the rules of the Michigan Board of Land Surveyors or by a Decree of a Court of Law; established, re-established, monumented, recovered, found as expressed below:

NOTE: Not more than 2 corners, all in the same town and range, may be recorded on this certificate.

A. Description of original monument and accessories and/or subsequent restoration:

(M5) Corner common to Sections 12-13 T46N-R34W and Sections 7-18 T46N-R33W. 1846 - Established by Austin Burt, Deputy Surveyor. Set Birch post. Fir 8 S60W 18 links, Sugar 8 N55E 21 links. 1852 - Additional BT by Francis Houck, Deputy Surveyor: Sugar 12 S68E 33 links. Found no subsequent record.

(1-Sec. 24) West 1/16 corner between Sections 13 and 24. Not established in the original survey. Found no subsequent record.

B. Description of corner evidence found and/or method applied in restoring or reestablishing corner:

(M5) The original post and accessories were not recovered. Found no evidence of the position of the original corner on the ground. Reestablished the corner by single proportionate measurement to the original record, on the Range line between Township corner 10464.33' north (GLO record = 158.62 chains) and Quarter corner 2638.84' south (GLO record 40.00 chains).

(1-Sec. 24) Established the corner midway and on the Section line between Section corner 1319.75' west and Quarter corner 1319.75' east.


C. Description of monument for corner and accessories established to perpetuate locating the position of the corner:

(M5) Set 1"IDx32" I.pipe with 4" alum. MDNR cap.	(1) Set 1"IDx32" I.pipe with 4" alum. MDNR cap.
Set a measuring nail with MDNR tag in:	Set a measuring nail with MDNR tag in:
6" Spruce N65E 17.0' mrkd "S7 NBT"	13" Tamarack S84W 32.35' mrkd "1/16S BT"
8" Spruce S73E 9.45' "S18 NBT"	9" Spruce N37W 7.2' do
9" Spruce S43W 22.8' "S13 NBT"	15" Tamarack N20E 26.35' do
9" Spruce N70W 32.2' "S12 NBT"	9" Spruce S25E 11.2' do
Set sq'd spruce post adjacent. Bearings are magnetic. Distances are to nail with tag in the side of tree.	Set sq'd tamarack post adjacent. Brgs are magnetic. Distances are to nail with tag in the side of tree.

	A	B	C	D	E	F	G	H	I	J	K	L	M
1													
2	6			5			4			3			2
3													
4	7			8			9			10			11
5													12
6	18			17			16			15			14
7													13
8	19			20			21			22			23
9													24
10	30			29			28			27			26
11													25
12	31			32			33			34			35
13													36

Register of Deeds Stamp & File Number

Signed by Stephan J. Szyszkoski

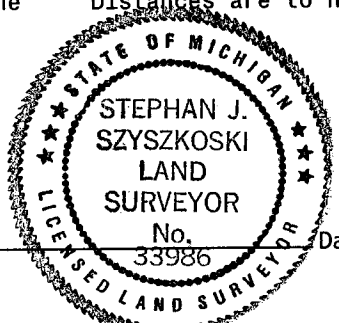

Date 11/6/07

Surveyor's Michigan License No. 33986