

SURVEY & REMONUMENTATION

FORM NO. 985-A



Stock No. 26273

MAR 19 1997

COMMISSION

LAND CORNER RECORDATION CERTIFICATE Filing Requirement of Act 74, Mich. P.A. 1970

For corners in

Iron _____ (County)	Located In:	Corner Code #
1. Public Land Survey	T 46N R 35W	<u>J-1</u>
	T 45N R 35W	_____
	T _____ R _____	_____
	T _____ R _____	_____
2. Property Controlling in Section	S _____ T _____ R _____	_____
	S _____ T _____ R _____	_____
3. Miscellaneous Property in Sec.	S _____ T _____ R _____	_____
	S _____ T _____ R _____	_____

IRON COUNTY
MICHIGAN
RECEIVED FOR RECORD
96 DEC 23 AM 8:53
L.C. Records L. 7, P. 27
Gilbert J. Pisoni
REGISTER OF DEEDS

Register of Deeds Stamp & File Number

4. Lot No. _____, Recorded Plat _____
5. Private Claims _____

Quarter Corner S.35, T46N R35W & S.2, T45N R35W

I, Gary L. Pisoni, in a field survey on October 11, 19 96 do hereby state that under requirements of P.A. 74, Michigan P.A. of 1970, the corner points mentioned in lines 1 and 2 above were in conformance with regulations and rules therefore as required in the current manual of survey instructions of the United States Department of the Interior, Bureau of Land Management or by a decree of a Court of Law and /or that the corner points mentioned in lines 3, 4 and 5 above were in conformance with the rules of the Michigan Board of Land Surveyors or by a Decree of a Court of Law; established, re-established, monumented, recovered, found as expressed below:

	A	B	C	D	E	F	G	H	I	J	K	L	M
1													
2	6		5		4		3		2		1		
3													
4	7		8		9		10		11		12		
5													
6	18		17		16		15		14		13		
7													
8	19		20		21		22		23		24		
9													
10	30		29		28		27		26		25		
11													
12	31		32		33		34		35		36		
13													

NOTE: Not more than 2 comers, all in the same town and range, may be recorded on this certificate.

A. Description of original monument and accessories and/or subsequent restoration:

Original corner established by William Burt, U.S. Deputy Surveyor on September 19, 1846.
Original corner: Fir Post
Original bearing trees:
Cedar 7" N 28° E 36 links (23.76 feet)
Sugar Maple 12" N 18° W 33 links (21.78 feet)

In 1965, Donald D. Lappala, R.L.S., set a 2" dia. X 5 feet long, concrete filled galvanized iron pipe with brass tablet from a found 4" x 4" cedar post and evidence from original bearing trees as described above.

Recorded in Land Corner Certificate L. 3, Page 226 on June 1, 1966.
1965 Bearing Trees:
Elm 12" N 84° W 23.5 feet
Red Maple 6" S 57° E 19.4 feet
Sugar Maple 3" S 61° W 14.5 feet

PEER GROUP APPROVED
Iron Gary L. Pisoni 12-11-96
COUNTY REPRESENTATIVE


B. Description of corner evidence found and/or method applied in restoring or reestablishing corner:

Found the monument and bearing trees as described above.
Red Maple 13" S 55° E 19.42 feet
Sugar Maple 5" S 62° W 14.30 feet
Sugar Maple 7" N 68° W 17.98 feet
Wood Sign Post N 19° W 2.30 feet

Corner Record Research on file with County Representative.

C. Description of monument for corner and accessories established to perpetuate locating the position of the corner:

From the above described brass cap monument, I established the following new blazed and scribed bearing tree: (all measurements taken to a nail in side of tree)
Sugar Maple 5" N 26° E 30.92 feet
Steel Sign Post 6' N 82° W 0.73 feet

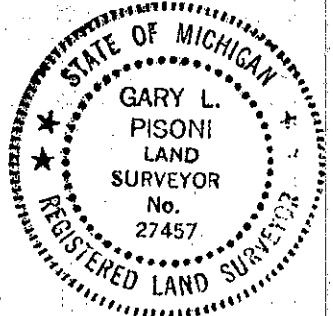

#96-05
Signed by Gary L. Pisoni Date 12-10-96
Surveyor's Michigan License No. 27457

L. 7 P. 27