

SURVEY & REMONUMENTATION

FORM NO. 985-A



Stock No. 26273

MAR 19 1997

COMMISSION

LAND CORNER RECORDATION CERTIFICATE
Filing Requirement of Act 74, Mich. P.A. 1970

IRON COUNTY
MICHIGAN
RECEIVED FOR RECORD

96 DEC 23 AM 8:52

L.C. Records 2.7, P. 26

Gilbert Stebbins
REGISTERED DEEDS

Register of Deeds Stamp & File Number

For corners in

Iron
(County)

Located In:

Corner Code #

1. Public Land Survey

~~T46N R35W~~ T46N R34W A-12

T ___ R ___
T ___ R ___
S ___ T ___ R ___
S ___ T ___ R ___
S ___ T ___ R ___
S ___ T ___ R ___

2. Property Controlling in Section

3. Miscellaneous Property in Sec.

4. Lot No. _____, Recorded Plat _____

5. Private Claims _____

Quarter Corner S 36, T46N R35W, S 31, T46N R34W

Gary L. Pisoni, in a field survey on October 10, 19 96 do hereby state that under requirements of P.A. 74, Michigan P.A. of 1970, the corner points mentioned in lines 1 and 2 above were in conformance with regulations and rules therefore as required in the current manual of survey instructions of the United States Department of the Interior, Bureau of Land Management or by a decree of a Court of Law and/or that the corner points mentioned in lines 3, 4 and 5 above were in conformance with the rules of the Michigan Board of Land Surveyors or by a Decree of a Court of Law; established, re-established, monumented, recovered, found as expressed below:

NOTE: Not more than 2 corners, all in the same town and range, may be recorded on this certificate.

	A	B	C	D	E	F	G	H	I	J	K	L	M
1													
2	6			5			4			3			2
3													
4	7			8			9			10			11
5													
6	18			17			16			15			14
7													
8	19			20			21			22			23
9													
10	30			29			28			27			26
11													
12	31			32			33			34			35
13													

3. Description of original monument and accessories and/or subsequent restoration:

Original corner established by William Burt, U.S. Deputy Surveyor on September 21, 1846.

Original corner: Ironwood Post

Original bearing trees:

Sugar	16"	S 32° E	22 links (14.52 feet)
Lynn	16"	N 70° W	17 links (11.22 feet)

4. Description of corner evidence found and/or method applied in restoring or reestablishing corner:

No original corner evidence found. Corner restored by single proportionate measurement methods on line between the Southwest and Northwest Section corners of Section 31, T46N R34W.


PEER GROUP APPROVED
Gary L. Pisoni 12-11-96
COUNTY REPRESENTATIVE

Corner Record Research on file with County Representative.

5. Description of monument for corner and accessories established to perpetuate locating the position of the corner:

At the corner position, I set a 2" diameter by 30" long split base aluminum pipe monument with a 3" cast aluminum cap, stamped to read: Iron County Remonumentation, T46N, R35W, R34W, 1/4, S-36, S-31, 1996, RLS-27457 from which I established the following new blazed and scribed bearing trees: (all measurements taken to a nail in side of tree)

Sugar Maple	5"	N 51° E	36.27 feet
Sugar Maple	7"	S 55° E	24.12 feet
Sugar Maple	11"	S 31° W	12.89 feet
Sugar Maple	10"	N 38° W	33.22 feet
Steel Sign Post	6'	N 46° E	0.74 feet

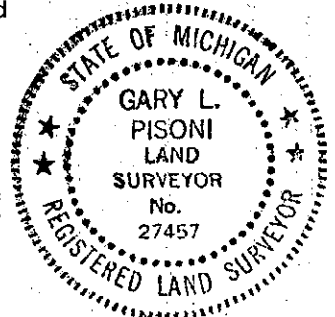

96-04
Signed by Gary L. Pisoni
Surveyor's Michigan License No. 27457

Date 12-10-96

L.7 P.26