



SURVEY & REMONUMENTATION

Stock No. 26273

MAR 19 1997

COMMISSION

LAND CORNER RECORDATION CERTIFICATE Filing Requirement of Act 74, Mich. P.A. 1970

IRON COUNTY
MICHIGAN
RECEIVED FOR RECORD

95 DEC 23 AM 8:51
L.C. Records L. 7, P. 25
Gilbert Stelica
REGISTER OF DEEDS

For corners in

Iron
(County)

Located In:

Corner Code #

1. Public Land Survey

T 46N R 35W	M-13
T 45N R 35W	M-1
T 46N R 34W	A-13
T 45N R 34W	A-1

2. Property Controlling in Section

S	T	R	
S	T	R	

3. Miscellaneous Property in Sec.

S	T	R	
S	T	R	

Register of Deeds Stamp & File Number

4. Lot No. _____, Recorded Plat _____

5. Private Claims _____

Section Corner 36, T46N R35W & 31, T46N R34W
1, T45N R35W & 6, T45N R34W

I, Gary L. Pisoni, in a field survey on October 10, 1996 do hereby state that under requirements of P.A. 74, Michigan P.A. of 1970, the corner points mentioned in lines 1 and 2 above were in conformance with regulations and rules therefore as required in the current manual of survey instructions of the United States Department of the Interior, Bureau of Land Management or by a decree of a Court of Law and/or that the corner points mentioned in lines 3, 4 and 5 above were in conformance with the rules of the Michigan Board of Land Surveyors or by a Decree of a Court of Law; established, re-established, monumented, recovered, found as expressed below:

NOTE: Not more than 2 corners, all in the same town and range, may be recorded on this certificate.

A	B	C	D	E	F	G	H	I	J	K	L	M
1												
2	6		5		4		3		2		1	
3												
4	7		8		9		10		11		12	
5												
6	18		17		16		15		14		13	
7												
8	19		20		21		22		23		24	
9												
10	30		29		28		27		26		25	
11												
12	31		32		33		34		35		36	
13												

A. Description of original monument and accessories and/or subsequent restoration:

Original corner established by William Burt, U.S. Deputy Surveyor on September 18, 1846.

Original corner: Sugar Post

Original bearing trees:

Sugar	8"	S 54° E	30 links (19.80 feet)
Lynn	18"	N 25° W	24 links (15.84 feet)

B. Description of corner evidence found and/or method applied in restoring or reestablishing corner:

No original corner evidence found. Found a 1 1/4" iron pipe, 3 feet above ground surface. Found a 3/4" dia. iron pin flush with ground surface. G.L.O. distance along Range line and Town line check good from iron pin to other G.L.O. corners found East, West, North and South. I accept the iron pin as the best available evidence for restoring the corner position.


PEER GROUP APPROVED
Iron Gary L. Pisoni 12-11-96
COUNTY REPRESENTATIVE

Corner Record Research on file with County Representative.

C. Description of monument for corner and accessories established to perpetuate locating the position of the corner:

At the corner position, I set a 2" diameter by 30" long split base aluminum pipe monument with a 3" cast aluminum cap, stamped to read: Iron County Remonumentation, T46N, R35W, R34W, S-36, S-31, S-1, S-6, T45N, 1996, RLS -27457 from which I established the following new blazed and scribed bearing trees: (all measurements taken to a nail in side of tree)

Iron Pipe	1 1/4" dia.	S. 75° 54' 50" E	16.17 feet
Sugar Maple	7"	N 24° E	20.19 feet
Sugar Maple	7"	N 77° E	14.54 feet
Sugar Maple	6"	S 71° W	9.31 feet
Sugar Maple	8"	N 81° W	24.34 feet
Steel Sign Post	6'	N 08° W	0.63 feet

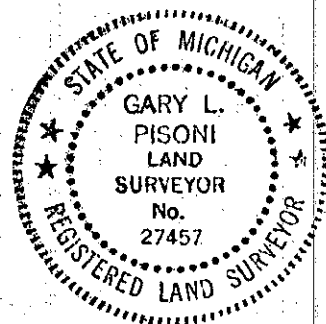

#96-03
Signed by *Gary L. Pisoni*

Date 12-10-96

Surveyor's Michigan License No. 27457

L. 7 P. 25