

MAR 09 2000

SECTION

LAND CORNER RECORDATION CERTIFICATE
Filing Requirement of Act 74, Mich. P.A. 1970

For corners in

<u>Iron</u> (County)	Located In:	Corner Code #
1. Public Land Survey	T <u>46N</u> R <u>37W</u>	<u>F-9</u>
	T _____ R _____	_____
	T _____ R _____	_____
	T _____ R _____	_____
2. Property Controlling in Section	S _____ T _____ R _____	_____
	S _____ T _____ R _____	_____
3. Miscellaneous Property in Sec.	S _____ T _____ R _____	_____
	S _____ T _____ R _____	_____

IRON COUNTY
MICHIGAN
RECEIVED FOR RECORD

99 DEC 30 AM 10:30
L.C. Records: L.S. P. 116
Richard Stelma
REGISTER OF DEEDS

Register of Deeds Stamp & File Number

4. Lot No. _____, Recorded Plat _____
5. Private Claims _____

Quarter corner between Sections 21 & 28, T46N R37W

I, Gary L. Pisoni, in a field survey on June 16, 1995 do hereby state that under requirements of P.A. 74, Michigan P.A. of 1970, the corner points mentioned in lines 1 and 2 above were in conformance with regulations and rules therefore as required in the current manual of survey instructions of the United States Department of the Interior, Bureau of Land Management or by a decree of a Court of Law and /or that the corner points mentioned in lines 3, 4 and 5 above were in conformance with the rules of the Michigan Board of Land Surveyors or by a Decree of a Court of Law; established, re-established, monumented, recovered, found as expressed below:

NOTE: Not more than 2 corners, all in the same town and range, may be recorded on this certificate.

A	B	C	D	E	F	G	H	I	J	K	L	M
1												
2	6		5		4		3		2		1	
3												
4	7		8		9		10		11		12	
5												
6	18		17		16		15		14		13	
7												
8	19		20		21		22		23		24	
9												
10	30		29		28		27		26		25	
11												
12	31		32		33		34		35		36	
13												

A. Description of original monument and accessories and/or subsequent restoration:

Original corner established by E. L. Martin, U.S. Deputy Surveyor on June 30, 1851.
Original corner: Wood Post
Original bearing trees:
Maple 8" S 82° W 11 links (7.26 feet)
Sugar 12" N 37° E 15 links (9.90 feet)

PEER GROUP APPROVED
Iron Aug 2 Per 12-21-99
COUNTY REPRESENTATIVE

B. Description of corner evidence found and/or method applied in restoring or reestablishing corner:

No original corner evidence found.


Set 1/4 corner by single proportionate measurement methods between the Southwest and Southeast section corners of Section 21.

Corner Record Research on file with County Representative.

C. Description of monument for corner and accessories established to perpetuate locating the position of the corner:

At the corner position, I set a 2" diameter by 30" long split base aluminum pipe monument with a 3" cast aluminum cap, stamped to read: Iron County Remonumentation, T46N, R37W, 1/4, S-21, S-28, 1995, RLS-27457 from which I established the following new blazed and scribed bearing trees: (all measurements taken to a nail in side of tree)

Red Maple	8"	S 33° W	40.22 feet
Red Maple	12"	N 51° W	31.53 feet
Red Maple	10"	N 10° E	34.82 feet
Hemlock	12"	S 83° E	44.73 feet
Steel Sign Post	6'	North	0.60 feet

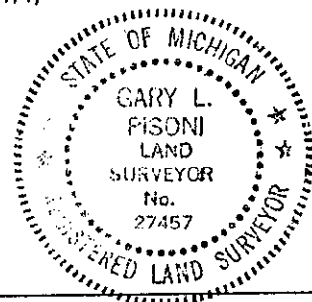

99-116
Signed by Gary L. Pisoni
Surveyor's Michigan License No. 27457

Date 12-28-99

FORM APPROVED BY MICHIGAN STATE BOARD OF PROFESSIONAL SURVEYORS, JAN. 28, 1971
REVISED MAY 14, 1975
REVISED JAN., 1983
REVISED OCT., 1995