

MAY 28 1997

LAND CORNER RECORDATION CERTIFICATE

IRON COUNTY MICHIGAN RECORD

COMMISSION

FILING REQUIREMENT OF ACT 74, MICH. P.A. 1970

DEC 10 PM 3:33
L.C. Records 8/29/12
Patrick R. Leemon
REGISTER OF DEEDS

FOR CORNERS OF--	LOCATED IN--	CORNER CODE NUMBER
1. PUBLIC LAND SURVEY	T. 46N N. S., R. 37W E. W.	H1
2. PROPERTY CONTROLLING IN SECTION	T. _____ N. S., R. _____ E. W.	
3. MISCELLANEOUS PROPERTY IN SECTION	T. _____ N. S., R. _____ E. W.	
4. LOT NO. _____, RECORDED PLAT _____		
5. PRIVATE CLAIMS _____		

REGISTER OF DEEDS STAMP AND FILING NUMBER

I, Patrick R. Leemon do hereby certify that under requirements of P.A. 74, Michigan P.A. of 1970, the corner points mentioned in lines 1 and 2 above (identified with circles on index code diagram - over) were, in a field survey on August 15, 1996, established, re-established, monumented, re-monumented, recovered or restored as expressed below and in conformance with regulations and rules therefore as required in the current manual of survey instructions of the United States Department of the Interior, Bureau of Land Management or by a decree of a court of law. Furthermore, that the corner points mentioned in lines 3, 4 and 5 above were, in a field survey on _____ 19____, found, recovered, restored, established or re-established as expressed below and in conformance with the rules of the Michigan State Board of Registration for Land Surveyors or, by a Decree of a Court of law:

A. Description of original monument and accessories and/or subsequent restoration:

1/4 Corner common to section 3 of T46N R37W and section 34 of T47N R37W
 1847 survey by Wm. A. & Austin Burt Set Sugar Post, (1) Hemlock 14 N72E 53 links, (2) Sugar 4 N31W 35 links

B. Description of corner evidence found and/or method applied in restoring or re-establishing corner:

I searched for but could not find evidence of the Burt corner. The area has been disturbed by road construction in the past. I recovered this corner by single proportional measurement between the NW 3 and the NE 2. The GLO feature calls support this location. This monument is intended to be a careful and faithful re-establishment of the position of the original corner.

County Research and Field Search information is on file with the County Representative.

C. Description of monument for corner and accessories established to perpetuate locating the position of the corner:

1/4 Corner common to section 3 of T46N R37W and section 34 of T47N R37W
 Monu. Set 2"x30" flared base aluminum pipe w/aluminum cap and magnet.
 Witnesses:
 Basswood 9 N54E 10.21 ft.
 S.Maple 9 N85E 13.56 ft.
 S.Maple 7 S21E 19.32 ft.
 S.Maple 11 S48W 21.79 ft.
 NW 3 N89-58-12W 2648.73 ft.
 NE 2 S89-58-12E 7946.19 ft.


SIGNED BY Patrick R. Leemon DATE August 15, 1996

SURVEYOR'S MICHIGAN REGISTRATION NO. 31595

FOR STATE AND UNITED STATES AGENCIES:

SIGNED BY _____ DATE _____
CHIEF OF SURVEY PARTY

APPROVED AND SIGNED BY _____ DATE _____
MICHIGAN REGISTERED LAND SURVEYOR

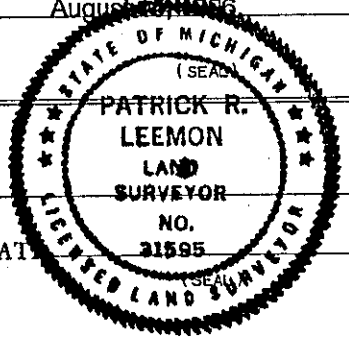

L.7 P.12

SURVEYOR'S MICHIGAN REGISTRATION NO. _____