

MAY 28 1997 LAND CORNER RECORDATION CERTIFICATE
COMMISSION FILING REQUIREMENT OF ACT 74, MICH. P.A. 1970

FOR CORNERS OF--:	LOCATED IN--:	CORNER CODE NUMBER
1. PUBLIC LAND SURVEY _____	T. <u>46N</u> N. S., R. <u>37W</u> E. W.	<u>H3</u>
2. PROPERTY CONTROLLING IN SECTION _____	T. _____ N. S., R. _____ E. W.	_____
3. MISCELLANEOUS PROPERTY IN SECTION _____	T. _____ N. S., R. _____ E. W.	_____
4. LOT NO. _____, RECORDED PLAT _____		
5. PRIVATE CLAIMS _____		

IRON COUNTY MICHIGAN
 RECEIVED FOR RECORD
 96 DEC 10 PM 3:34
L. J. P. 19
Gilbert J. Stiles
 REGISTER OF DEEDS
 REGISTER OF DEEDS STAMP AND FILING NUMBER

I, Patrick R. Leemon do hereby certify that under requirements of P.A. 74, Michigan P.A. of 1970, the corner points mentioned in lines 1 and 2 above (identified with circles on index code diagram—over) were, in a field survey on August 15, 1996, established, re-established, monumented, re-monumented, recovered or restored as expressed below and in conformance with regulations and rules therefore as required in the current manual of survey instructions of the United States Department of the Interior, Bureau of Land Management or by a decree of a court of law. Furthermore, that the corner points mentioned in lines 3, 4 and 5 above were, in a field survey on _____ 19____, found, recovered, restored, established or re-established as expressed below and in conformance with the rules of the Michigan State Board of Registration for Land Surveyors or, by a Decree of a Court of law:

A. Description of original monument and accessories and/or subsequent restoration:

1/4 Corner common to section 3 and 10 of T46N R37W

1851 survey by Elias C. Martin Set Cedar Post, (1) Y. Birch 12 S82W 13 links, (2) Hemlock 18 N57E 17 links
 1937 search by T.J. Hamalainen U.S.F.S. Fd. a 3" cedar stake sticking 48" above the surface.

B. Description of corner evidence found and/or method applied in restoring or re-establishing corner:

I searched for but could not find evidence of the Martin corner. The area has been disturbed by recent heavy logging. I recovered this corner by single proportional measurement between the SW 3 and the SE 3. The GLO stream call to the East is in error by approximately 10 chains and is of no aid to this recovery attempt. This monument is intended to be a careful and faithful re-establishment of the position of the original corner.

County Research and Field Search information is on file with the County Representative.

C. Description of monument for corner and accessories established to perpetuate locating the position of the corner:

1/4 Corner common to section 3 and 10 of T46N R37W
 Monu. Set 2"x30" flared base aluminum pipe w/aluminum cap and magnet.
 Witnesses:
 Aspen 2 N88W 33.02 ft.
 Aspen 2 N10W 10.03 ft.
 Spruce 5 S08W 13.43 ft.
 Aspen 2 S65W 33.84 ft.
 SW 3 N89-21-52W 2657.56 ft.
 SE 3 S89-21-52E 2657.57 ft.
 C1/4 3 N 0-47-04W 2633.76 ft.


SIGNED BY *Patrick R. Leemon* DATE August 15, 1996

SURVEYOR'S MICHIGAN REGISTRATION NO. 31595

FOR STATE AND UNITED STATES AGENCIES:

SIGNED BY _____ DATE _____
CHIEF OF SURVEY PARTY

APPROVED AND SIGNED BY _____ DATE _____
MICHIGAN REGISTERED LAND SURVEYOR

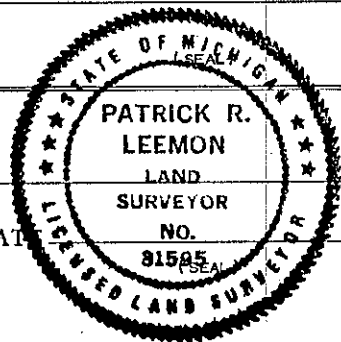

L. J. P. 19

SURVEYOR'S MICHIGAN REGISTRATION NO. _____