

**SURVEY & REMONUMENTATION**

JAN 19 1999

**SECTION**

**LAND CORNER RECORDATION CERTIFICATE**  
Filing Requirement of Act 74, Mich. P.A. 1970

For corners in

Iron (County)	Located In:	Corner Code #
1. Public Land Survey	T <u>46N</u> R <u>37W</u>	<u>J-9</u>
	T _____ R _____	_____
	T _____ R _____	_____
	T _____ R _____	_____
2. Property Controlling in Section	S _____ T _____ R _____	_____
	S _____ T _____ R _____	_____
3. Miscellaneous Property in Sec.	S _____ T _____ R _____	_____
	S _____ T _____ R _____	_____

IRON COUNTY  
MICHIGAN  
RECEIVED FOR RECORD

98 DEC 28 AM 11:25  
L.C. Records: L. 7, P. 314  
*Richard Stiles*

Register of Deeds Stamp & File Number

4. Lot No. \_\_\_\_\_, Recorded Plat \_\_\_\_\_  
5. Private Claims \_\_\_\_\_

Quarter Corner Sections 23, and 26, T46N, R37W

I, Gary L. Pisoni, in a field survey on Dec. 16, 1998 do hereby state that under requirements of P.A. 74, Michigan P.A. of 1970, the corner points mentioned in lines 1 and 2 above were in conformance with regulations and rules therefore as required in the current manual of survey instructions of the United States Department of the Interior; Bureau of Land Management or by a decree of a Court of Law and /or that the corner points mentioned in lines 3, 4 and 5 above were in conformance with the rules of the Michigan Board of Land Surveyors or by a Decree of a Court of Law; established, re-established, monumented, recovered, found as expressed below:

	A	B	C	D	E	F	G	H	I	J	K	L	M
1													
2		6		5		4		3		2		1	
3													
4		7		8		9		10		11		12	
5													
6		18		17		16		15		14		13	
7													
8		19		20		21		22		23		24	
9										●			
10		30		29		28		27		26		25	
11													
12		31		32		33		34		35		36	
13													

**NOTE:** Not more than 2 corners, all in the same town and range, may be recorded on this certificate.

A. Description of original monument and accessories and/or subsequent restoration:

Original corner established in 1851 by E. C. Martin, U.S. Deputy Surveyor.  
Original Corner; Tamarack Post  
Original Bearing Trees:

Spruce	6"	S 31° W	6 lks (3.96 feet)
White Pine	8"	N 21° E	18 lks (11.88 feet)

On 6/11/63, Donald D. Lappala RLS U.S. Forest Service restored the corner position from the remains of the original white pine bearing tree stump, set a 2" diameter by 5' long galvanized iron pipe with a 3" brass cap stamped as follows: T46N, R37W, 1/4, S-23, S-26, RLS 12585, 1963, 18" above ground surface recorded in L.C. Certificate Liber 2b, Page 256 on 4/8/65.

1963 Bearing Trees:

White Pine	16"	S 27°30'W	25.7 feet
Sugar Maple	20"	N 51°W	65.8 feet
White Pine	19"	N 26°30'E	3.9 feet

B. Description of corner evidence found and/or method applied in restoring or reestablishing corner:

No evidence of original B.T.s found. Found monument as described above and the following bearing trees:

Sugar Maple	22"	N 52°W	65.85 feet
White Pine	26"	N 27°E	3.94 feet
Yellow Birch	14"	South	16.73 feet
White Pine	19"	S 28°W	25.65 feet

I accept the above monument as the best available evidence for restoring the corner position.

Corner record research on file with County Representative.

PEER GROUP APPROVED  
*Iron Co. Rep. 12-18-98*  
COUNTY REPRESENTATIVE


C. Description of monument for corner and accessories established to perpetuate locating the position of the corner:

New corner reference:

Steel sign post S 63°E 1.0 feet

98-152  
Signed by Gary L. Pisoni Date 12-21-98  
Surveyor's Michigan License No. 27457

FORM APPROVED BY MICHIGAN STATE BOARD OF PROFESSIONAL SURVEYORS, JAN. 28, 1971

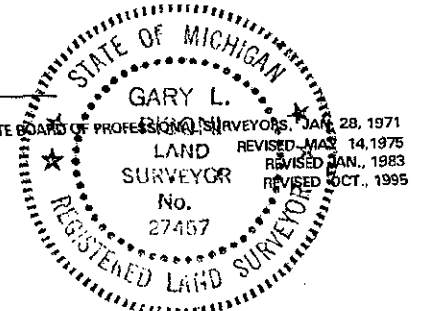

L. 7 P. 314