

MAY 28 1997

LAND CORNER RECORDATION CERTIFICATE
COMMISSION FILING REQUIREMENT OF ACT 74, MICH. P.A. 1970

FOR CORNERS OF--	LOCATED IN--	CORNER CODE NUMBER
1. PUBLIC LAND SURVEY _____	T. <u>46N</u> N. S., R. <u>37W</u> E. W.	<u>K1</u>
2. PROPERTY CONTROLLING IN SECTION _____	, T. _____ N. S., R. _____ E. W.	_____
3. MISCELLANEOUS PROPERTY IN SECTION _____	, T. _____ N. S., R. _____ E. W.	_____
4. LOT NO. _____	, RECORDED PLAT _____	_____
5. PRIVATE CLAIMS _____	_____	_____

IRON COUNTY
MICHIGAN
RECEIVED FOR RECORD
95 DEC 10 PM 3: 33
J.C. Reynolds L.P. 15
Patrick R. Leemon
REGISTER OF DEEDS
REGISTER OF DEEDS STAMP AND FILING NUMBER

I, Patrick R. Leemon do hereby certify that under requirements of P.A. 74, Michigan P.A. of 1970, the corner points mentioned in lines 1 and 2 above (identified with circles on index code diagram—over) were, in a field survey on August 15, 1996, established, re-established, monumented, re-monumented, recovered or restored as expressed below and in conformance with regulations and rules therefore as required in the current manual of survey instructions of the United States Department of the Interior, Bureau of Land Management or by a decree of a court of law. Furthermore, that the corner points mentioned in lines 3, 4 and 5 above were, in a field survey on _____ 19____, found, recovered, restored, established or re-established as expressed below and in conformance with the rules of the Michigan State Board of Registration for Land Surveyors or, by a Decree of a Court of law:

A. Description of original monument and accessories and/or subsequent restoration:

Section corner common to sec's. 1 & 2 of T46N R37W and sec's. 35 & 36 of T47N R37W

1847 survey by Wm. A. & Austin Burt Set Sugar Post, (1) Hemlock 12 N16E 28 links, (2) Hemlock 20 N22W 20 links
1851 survey by Elias C. Martin Fd. Post (3) Maple 18 S16E 38 links, (4) Hemlock 24 S57W 24 links
1994 survey by Richard L. Drahn #21564 Set 2"x30" flared base aluminum pipe with aluminum cap and magnet, (5) S.Maple 20 N21E 11.19 ft., (6) S.Maple 10 S30E 17.41 ft., (7) S.Maple 10 S45W 12.69 ft.
(8) Steel sign post S79W 0.57 ft.

B. Description of corner evidence found and/or method applied in restoring or re-establishing corner:

I found the 2"x30" flared base aluminum pipe with aluminum cap and magnet by Drahn in good condition. Witnesses 1 through 4 are gone. Witness 6 is a stump. Witnesses 5, 7 and 8 are in good condition. Liber 6 Page 386 by Drahn documents the history of this corner. This monument is accepted as a careful and faithful perpetuation of the position of the original corner.

County Research and Field Search information is on file with the County Representative.

C. Description of monument for corner and accessories established to perpetuate locating the position of the corner:

Section corner common to sec's. 1 & 2 of T46N R37W and sec's. 35 & 36 of T47N R37W

Monu. The 2"x30" flared base aluminum pipe with aluminum cap and magnet was left in place.
Witnesses:
60d spike in the west side of a S.Maple 10 N8W 53.72 ft.
60d spike in the north side of a S.Maple 9 N65W 45.50 ft.
S.Maple 10 S45W 12.69 ft.
S.Maple 20 N21E 11.19 ft.
Steel fence rail 6' S84W 0.48 ft.

SIGNED BY Patrick R. Leemon DATE August 15, 1996


SURVEYOR'S MICHIGAN REGISTRATION NO. 31595

FOR STATE AND UNITED STATES AGENCIES:

SIGNED BY _____ DATE _____
CHIEF OF SURVEY PARTY

APPROVED AND SIGNED BY _____ DATE _____
MICHIGAN REGISTERED LAND SURVEYOR

L.P. 15

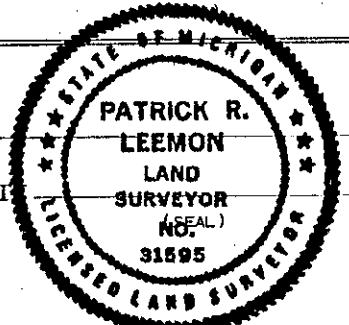

SURVEYOR'S MICHIGAN REGISTRATION NO. _____