

JAN 12 1996

COMMISSION

LAND CORNER RECORDATION CERTIFICATE  
Filing Requirement of Act 74, Mich. P.A. 1970

For corners in

HOUGHTON & IRON  
(County)

Located In:

Corner Code ~~##~~

1. Public Land Survey

T 47-46N R 37W

M-1  
~~M-13~~

2. Property Controlling in Section  
3. Miscellaneous Property in Sec.

S \_\_\_ T \_\_\_ R \_\_\_  
S \_\_\_ T \_\_\_ R \_\_\_  
S \_\_\_ T \_\_\_ R \_\_\_  
S \_\_\_ T \_\_\_ R \_\_\_

4. Lot No. \_\_\_\_\_, Recorded Plat \_\_\_\_\_  
5. Private Claims \_\_\_\_\_

Section Corner, Sections 36, 31, 1, 6; T.47-46N., R37-36W.

I, Richard L. Drahn, in a field survey on December 6, 1993 do hereby certify that under requirements of P.A. 74, Michigan P.A. of 1970, the corner points mentioned in lines 1 and 2 above were in conformance with regulations and rules therefore as required in the current manual of survey instructions of the United States Department of the Interior, Bureau of Land Management or by a decree of a Court of Law and/or that the corner points mentioned in lines 3, 4 and 5 above were in conformance with the rules of the Michigan Board of Land Surveyors or by a Decree of a Court of Law; established, re-established, monumented, re-monumented, recovered, found as expressed below: Southeast Township Corner of T.47N., R.37W.

NOTE: Not more than 4 corners, all in the same town and range, may be recorded on this certificate.

A. Description of original monument and accessories and/or subsequent restoration:

Corner established by John Burt, U.S. Deputy Surveyor, on September 22, 1846. Original bearing trees:

Y. Birch	24"	S.57°E.	12 links	( 7.92 feet)
Sugar	20"	N.60°W.	46 links	(30.36 feet)

B. Description of corner evidence found and/or method applied in restoring or reestablishing corner:

Restored corner position by retracement measurement from recovered corners and from natural features; north, south, east and west.

Research on file with County Representative.

C. Description of monument for corner and accessories established to perpetuate locating the position of the corner:

At the corner position I set a standard 2" diameter by 30" long split base aluminum monument with a 3 1/2" aluminum cap stamped to read: T.47-46N., R.37-36W.; S.36, S.1, S.31, S.6; 1993; R.L.S. 21564: from which I established the following new blazed scribed bearing trees and/or reference objects:

10"	Sugar Maple	N.46°W.	23.62 feet
10"	Sugar Maple	N.11°W.	18.80 feet
10"	Sugar Maple	N.31°E.	20.43 feet

A 6' steel sign post bears: South 0.73 feet.


REGISTERS OFFICE ) SS  
IRON COUNTY, MICH. )  
RECEIVED FOR RECORD THE 1<sup>ST</sup> DAY OF  
MARCH A.D. 19 95 AT  
3:45 O'CLOCK P. M. AND RECORDED IN LIBER  
6 OF L.C. RECORDS  
ON PAGE 385  
Mark Selko  
DEPUTY REGISTER OF DEEDS

Register of Deeds Stamp & File Number

A	B	C	D	E	F	G	H	I	J	K	L	M
2	6	5	4	3	2	1						
3												
4	7	8	9	10	11	12						
5												
6	18	17	16	15	14	13						
7												
8	19	20	21	22	23	24						
9												
10	30	29	28	27	26	25						
11												
12	31	32	33	34	35	36						
13												

PEER GROUP APPROVED

Iron County 4-7-94  
COUNTY REPRESENTATIVE

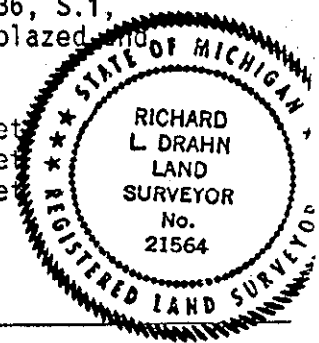

Signed by Richard L. Drahn Date February 11, 1994

Surveyor's Michigan License No. 21564

U.S.F.S. A-25

LIBER

6 PAGE 385