

**SURVEY &  
REMONUMENTATION**

APR 27 1995  
98320  
COMMISSION

**REMONUMENTATION CORNER  
LAND CORNER RECORDATION CERTIFICATE  
Filing Requirement of Act 74, Mich. P.A. 1970**

For corners in

ISABELLA  
(County)

Located In:

Corner Code #

1. Public Land Survey

T 13N R R4W

A-4 ✓

T 13N R R5W

M-4

T \_\_\_\_\_ R \_\_\_\_\_

T \_\_\_\_\_ R \_\_\_\_\_

2. Property Controlling  
in Section

S \_\_\_\_\_ T \_\_\_\_\_ R \_\_\_\_\_

S \_\_\_\_\_ T \_\_\_\_\_ R \_\_\_\_\_

3. Miscellaneous  
Property in Sec.

S \_\_\_\_\_ T \_\_\_\_\_ R \_\_\_\_\_

S \_\_\_\_\_ T \_\_\_\_\_ R \_\_\_\_\_

4. Lot No. \_\_\_\_\_, Recorded Plat \_\_\_\_\_

5. Private Claims \_\_\_\_\_

STATE OF MICHIGAN  
COUNTY OF ISABELLA  
RECEIVED FOR RECORD

MAR 23 12 PM '95  
30  
SHARON A. BROWN  
REGISTER OF DEEDS

Register of Deeds Stamp & File Number

Wm. B. Ruddell, in a field survey on November, 19 94

do hereby certify that under requirements of P.A. 74, Michigan P.A. of 1970, the corner points mentioned in lines 1 and 2 above were in conformance with regulations and rules therefore as required in the current manual of survey instructions of the United States Department of the Interior, Bureau of Land Management or by a decree of a Court of Law and/or that the corner points mentioned in lines 3, 4 and 5 above were in conformance with the rules of the Michigan Board of Land Surveyors or by a Decree of a Court of Law; established, re-established, monumented, re-monumented, recovered, found as expressed below:

**NOTE: Not more than 4 corners, all in the same town and range, may be recorded on this certificate.**

**THIS IS A COMMON CORNER**

A. Description of original monument and accessories and/or subsequent restoration:


1837 - Post

1980 - Found 3/4" Pipe (LCRD, Page 621)

1977 - Found 3/4" Pipe

1991 - Found 3/4" Pipe - LCRC, Page 1102

1994 - Found 3/4" Pipe

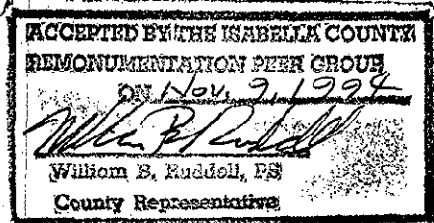

B. Description of corner evidence found and/or method applied in restoring or reestablishing corner:

1994 - Found 3/4" Pipe, excavated found 12" dia. stone along side of pipe, held 3/4" Pipe

And is accepted as a careful and faithful perpetuation fo the position of the original corner.


C. Description of monument for corner and accessories established to perpetuate locating the position of the corner:

1994 - Replaced 3/4" pipe with standard monument, marked M-4, A-4, in monument box, Set 5" + below grade

Witnesses: NW, 48.38', N&C in Telephone Pole  
NNE, 73.39', N&C in Fence Post  
SSW, 61.94', N&C in Fence Post  
WSW, 54.62', N&C in fence post

Signed by

*William B. Ruddell*

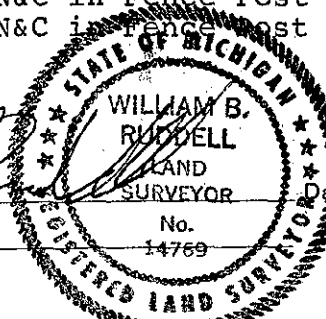

December 30, 1994

Surveyor's Michigan License No. 14769