

**SURVEY &
REMONUMENTATION**

98323

APR 27 1995

**COMMISSION REMONUMENTATION CORNER
LAND CORNER RECORDATION CERTIFICATE
Filing Requirement of Act 74, Mich. P.A. 1970**

For corners in

ISABELLA
(County)

Located In:

Corner Code #/

- | | | |
|---------------------------------------|--------------------------|------------|
| 1. Public Land Survey | T <u>13N</u> R <u>4W</u> | <u>C-4</u> |
| | T _____ R _____ | _____ |
| | T _____ R _____ | _____ |
| | T _____ R _____ | _____ |
| 2. Property Controlling in Section | S _____ T _____ R _____ | _____ |
| | S _____ T _____ R _____ | _____ |
| 3. Miscellaneous Property in Sec. | S _____ T _____ R _____ | _____ |
| | S _____ T _____ R _____ | _____ |
| 4. Lot No. _____, Recorded Plat _____ | | |
| 5. Private Claims _____ | | |

STATE OF MICHIGAN
COUNTY OF ISABELLA
RECEIVED

MAR 23 12 PM '95

SHARON A. BROWN
REGISTER OF DEEDS

Register of Deeds Stamp & File Number

I, Wm. B. Ruddell, in a field survey on November, 19 94

do hereby certify that under requirements of P.A. 74, Michigan P.A. of 1970, the corner points mentioned in lines 1 and 2 above were in conformance with regulations and rules therefore as required in the current manual of survey instructions of the United States Department of the Interior, Bureau of Land Management or by a decree of a Court of Law and/or that the corner points mentioned in lines 3, 4 and 5 above were in conformance with the rules of the Michigan Board of Land Surveyors or by a Decree of a Court of Law; established, re-established, monumented, re-monumented, recovered, found as expressed below:

NOTE: Not more than 4 corners, all in the same town and range, may be recorded on this certificate.

	A	B	C	D	E	F	G	H	I	J	K	L	M
2	6		5		4		3		2		1		
3													
4	7		8		9		10		11		12		
5													
6	18		17		16		15		14		13		
7													
8	19		20		21		22		23		24		
9													
10	30		29		28		27		26		25		
11													
12	31		32		33		34		35		36		
13													


A. Description of original monument and accessories and/or subsequent restoration:

- 1838 - Post
- 1974 - Found 1/2" Re-rod
- 1976 - Found 1/2" Re-rod
- 1994 - Found 1/2" Re-rod
- 1973 - Set 5/8" Re-rod - John Radcliffe

B. Description of corner evidence found and/or method applied in restoring or reestablishing corner:

- 1994 - Witnessed and removed re-rod augered to depth of 4' +, found no other evidence. Replaced re-rod with standard monument.

And is accepted as a careful and faithful reestablishment of the position of the original corner.

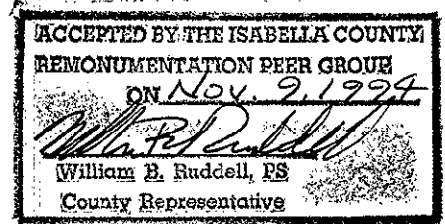


C. Description of monument for corner and accessories established to perpetuate locating the position of the corner:

- 1994 - Standard monument, marked C-4, in monument box. Set flush to bit. surface.

- Witnesses:
- ENE, 41.19', Nail & Cap in 40" Willow
 - NNW, 98.9', Nail & Cap in Power Pole
 - NNE, 91.1', Nail & Cap in clump white Birch
 - SSE, 87.1', Nail & Cap in 12" Tree

Signed by

William B. Ruddell

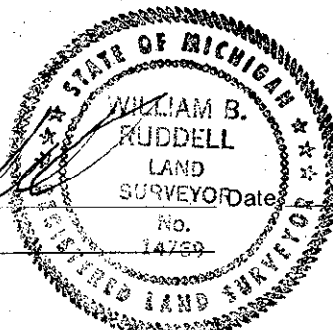

Date: November 16, 1994

Surveyor's Michigan License No. 14769