

**SURVEY &
REMONUMENTATION**

116480

MAY 05 1997

COMMISSION CORNER RECORDATION CERTIFICATE
Filing Requirement of Act 74, Mich. P.A. 1970
Isabella County Remonumentation

For Corners in
Isabella

(County)

Located In:

Corner Code#:

- | | | |
|---------------------------------------|--------------------------------|------------|
| 1. Public Land Survey | T. <u>13 N.</u> R. <u>5 W.</u> | <u>D-9</u> |
| | T. _____ R. _____ | _____ |
| | T. _____ R. _____ | _____ |
| 2. Public Controlling in Section | S. _____ T. _____ R. _____ | _____ |
| | S. _____ T. _____ R. _____ | _____ |
| 3. Miscellaneous Property in Section | S. _____ T. _____ R. _____ | _____ |
| | S. _____ T. _____ R. _____ | _____ |
| 4. Lot No. _____, Recorded Plat _____ | | |
| 5. Private Claims _____ | | |

STATE OF MICHIGAN
COUNTY OF ISABELLA
RECEIVED RECORD

Dec 26 9 20 AM '96
000104

SHARON A. BROWN
REGISTER OF DEEDS

Register of Deeds Stamp & File Number


I, Jan S. Fokens, in a field survey on Oct., 1996, do hereby state that under requirements of P.A. 74, Michigan P.A. of 1970, the corner points mentioned in lines 1 and 2 above were in conformance with regulations and rules therefore as required in the current manual of survey instructions of the United States Department of the Interior, Bureau of Land Management or by a decree of a Court of Law and/or that the corner points mentioned in lines 3, 4 and 5 above were in conformance with the rules of the Michigan Board of Land Professionals or by a Decree of a Court of Law, established, re-established, monumented, recovered, found as expressed below.

1	A	B	C	D	E	F	G	H	I	J	K	L	M
2	6	5	4	3	2	1							
3													
4	7	8	9	10	11	12							
5													
6	18	17	16	15	14	13							
7													
8	19	20	21	22	23	24							
9													
10	30	29	28	27	26	25							
11													
12	31	32	33	34	35	36							
13													

NOTE: Not more than 2 corners, all in the same town and range, may be recorded on this certificate.

A. Description of original monument and accessories and/or subsequent restoration:

- Original G.L.O. Survey:
Township lines 2nd quarter 1837 John Hodgson
Subdivision & Re-survey 4th quarter 1838 R. Whitcomb
Page 366 and 368 original field notes
- County Survey Records:
Book 3 Page 11 Dated 1890 E.R. Coburn
- L.C.R.C.:
Liber 2 Page 505 William Ruddell December 21, 1978
Liber 2 Page 538 William Ruddell September 13, 1979
- Surveys of Record:
Liber 5, Page 474 Found 1 1/2 inch pipe
Liber 5, Page 532 Found Iron in monument box

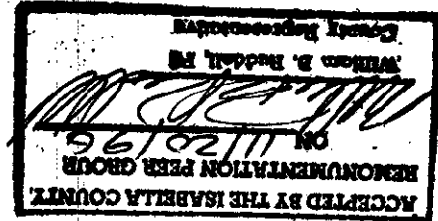

Found 1/2" gas pipe raised with 3/4" pipe
Found pipe in monument box


B. Description of corner evidence found and/or method applied in restoring or re-establishing corner:

- This corner established in Isabella County Remonumentation Program. See dossier for detailed report.
- Found 1" pipe 24" long in monument box 0.7 feet deep
 - Found 1/2" pipe running diagonally in hole
 - Found rock next to pipe
 - Excavated to depth of 4' - No evidence of further material

Accepted as best available evidence of the position of the original corner and replaced with Standard Monument Corner D-9 was approved for remonumentation at a Peer Review Committee meeting on November 20, 1996.

C. Description of monument for corner and accessories established to perpetuate locating the position of the corner:

- Set Standard Isabella County Monument in Monument Box.
- S.10°W., 34.7', top center of telephone box
 - S.11°E., 77.9', tag 14" Twin Oak
 - S.51°W., 153.1', corner mobile home
 - S.89°-49'-46"W., 2692.60' SE. corner Section 20 (E-9) T.13N.-R.5W.

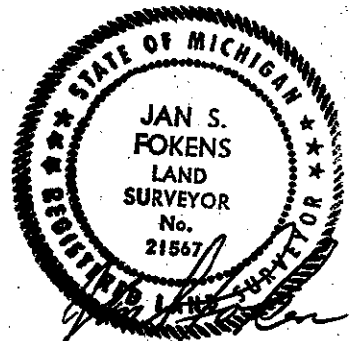

Signed by Jan S. Fokens
Surveyor's Michigan License No. 21567

Date Dec. 17, 1996