

**SURVEY &  
REMONUMENTATION**

MAY 05 1997

**116482**

**CORNER RECORDATION CERTIFICATE**  
**Filing Requirement of Act 74, Mich. P.A. 1970**  
**Isabella County Remonumentation**

For Corners in  
Isabella

(County)

Located In:

Corner Code#:

- |                                      |                                |            |
|--------------------------------------|--------------------------------|------------|
| 1. Public Land Survey                | T. <u>13 N.</u> R. <u>5 W.</u> | <u>E-8</u> |
|                                      | T. _____ R. _____              | _____      |
|                                      | T. _____ R. _____              | _____      |
| 2. Public Controlling in Section     | S. _____ T. _____ R. _____     | _____      |
|                                      | S. _____ T. _____ R. _____     | _____      |
| 3. Miscellaneous Property in Section | S. _____ T. _____ R. _____     | _____      |
|                                      | S. _____ T. _____ R. _____     | _____      |
| 4. Lot No. _____, Recorded Plat      |                                | _____      |
| 5. Private Claims                    |                                | _____      |

STATE OF MICHIGAN  
COUNTY OF ISABELLA  
RECEIVED \_\_\_\_\_ 30RD

DEC 26 9 20 AM '96  
**000106**  
SHARON A. BROWN  
REGISTER OF DEEDS

Register of Deeds Stamp & File Number

I, Jan S. Fokens, in a field survey on Oct., 1996, do hereby state that under requirements of P.A. 74, Michigan P.A. of 1970, the corner points mentioned in lines 1 and 2 above were in conformance with regulations and rules therefore as required in the current manual of survey instructions of the United States Department of the Interior, Bureau of Land Management or by a decree of a Court of Law and/or that the corner points mentioned in lines 3, 4 and 5 above were in conformance with the rules of the Michigan Board of Land Professionals or by a Decree of a Court of Law, established, re-established, monumented, recovered, found as expressed below.

**NOTE: Not more than 2 corners, all in the same town and range, may be recorded on this certificate.**

	A	B	C	D	E	F	G	H	I	J	K	L	M
2	6	5	4	3	2	1							
3													
4	7	8	9	10	11	12							
5													
6	18	17	16	15	14	13							
7													
8	19	20	21	22	23	24							
9													
10	30	29	28	27	26	25							
11													
12	31	32	33	34	35	36							
13													

**A. Description of original monument and accessories and/or subsequent restoration:**

**1. Original G.L.O. Survey:**

Township lines 2nd quarter 1837 John Hodgson  
Subdivision & Re-survey 4th quarter 1838 R. Whitcomb  
Page 356 original field notes

**2. County Survey Records:**

Book 3, Page 85 April 1897 William H. Trussell

**3. L.C.R.C.:**

Book 2, Page 661 Thomas J. Mueller September 21, 1981 Found nothing, Set "T" iron

**4. Surveys of Record:**

Liber 3, Page 588 Set "T" iron equidistant on line  
Liber 5, Page 474 Found "T" iron

**5. Unrecorded Surveys:**

R.E.I. files Set "T" iron

**B. Description of corner evidence found and/or method applied in restoring or re-establishing corner:**

This corner established in Isabella County Remonumentation Program. See dossier for detailed report.

**1. Found "T" bar at surface**

**2. Excavated to depth of 4' - No evidence of further material**

Accepted as best available evidence of the position of the original corner and replaced with Standard Monument Corner E-8 was approved for remonumentation at a Peer Review Committee meeting on November 20, 1996.

**C. Description of monument for corner and accessories established to perpetuate locating the position of the corner:**

Set Standard Isabella County Monument in Monument Box.



S.38°E., 47.9' Found tag on fence post

N.83°W., 27.3' Found tag on twin Maple

S.50°W., 40.5' Found tag on 14" Maple

S.00°-18'-33"W., 2685.89', SE. Corner (E-9) T.13N.-R.5W.

N.00°-18'-33"E., 2685.90', NE. Corner (E-7) T.13N.-R.5W.

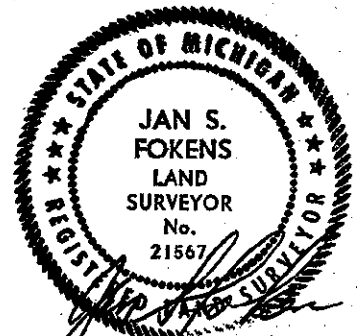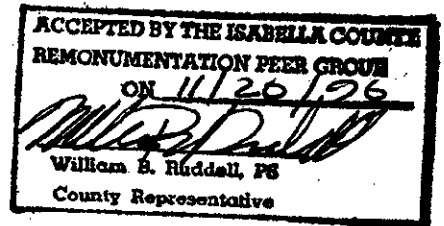

Signed by Jan S. Fokens  
Surveyor's Michigan License No. 21567

Date Dec. 17, 1996