

116483

LAND CORNER RECORDATION CERTIFICATE
Filing Requirement of Act 74, Mich. P.A. 1970
Isabella County Remonumentation

For Corners in
Isabella
(County)

Located In: Corner Code#:

- 1. Public Land Survey T. 13 N. R. 5 W. E-9
2. Public Controlling in Section S. T. R.
3. Miscellaneous Property in Section S. T. R.
4. Lot No. Recorded Plat
5. Private Claims

STATE OF MICHIGAN
COUNTY OF ISABELLA
RECEIVED FOR RECORD

Dec 26 9 20 AM '96
000107
SHARON A. BROWN
REGISTER OF DEEDS

Register of Deeds Stamp & File Number


I, Jan S. Fokens, in a field survey on Nov., 1996, do hereby state that under requirements of P.A. 74, Michigan P.A. of 1970, the corner points mentioned in lines 1 and 2 above were in conformance with regulations and rules therefore as required in the current manual of survey instructions of the United States Department of the Interior, Bureau of Land Management or by a decree of a Court of Law and/or that the corner points mentioned in lines 3, 4 and 5 above were in conformance with the rules of the Michigan Board of Land Professionals or by a Decree of a Court of Law, established, re-established, monumented, recovered, found as expressed below.

Grid table with columns A-M and rows 1-13. Contains numbers 1-36 and a small dot in row 9, column G.

NOTE: Not more than 2 corners, all in the same town and range, may be recorded on this certificate.

A. Description of original monument and accessories and/or subsequent restoration:

- 1. Original G.L.O. Survey: Township lines 2nd quarter 1837 John Hodgson Subdivision & Re-survey 4th quarter 1838 R. Whitcomb Page 356 original field notes
2. County Survey Records: Book 3, Page 85 April 1897 William H. Trussell
3. L.C.R.C.: Liber 1, Page 321 Jerry L. Jones February 27, 1975
4. Surveys of Record: None
5. Unrecorded Surveys: None

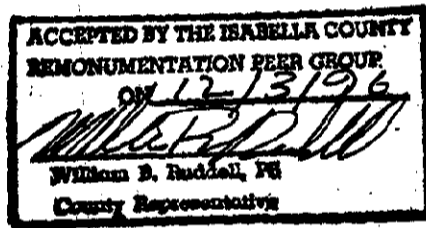

Found 1" pipe in monument box

B. Description of corner evidence found and/or method applied in restoring or re-establishing corner: This corner established in Isabella County Remonumentation Program. See dossier for detailed report.

- 1. Found 1" X 2.5' pipe (bent to West) in monument box 0.4" deep
2. Excavated to depth of 3.0' - No evidence of further material

Accepted as best available evidence of the position of the original corner and replaced with Standard Monument Corner E-9 was approved for remonumentation at a Peer Review Committee meeting on December 3, 1996.

C. Description of monument for corner and accessories established to perpetuate locating the position of the corner:

- Set Standard Isabella County Monument in Monument Box.
N.35°E., 76.10' SW. corner of white Winn telephone comm. box
S.15°W., 92.75' Found nail and tag in E. face of 8" Oak
S.45°W., 90.70' Found nail and tag in NW. face of power pole
N.25°W., 48.45' Set nail and tag in 6" post (marks culvert)
N.00°-18'-33"E., 2685.89', E.1/4 corner (E-8) T.13N.-R.5W.

SURVEY & REMONUMENTATION
MAY 05 1997
COMMISSION



Signed by [Signature]
Surveyor's Michigan License No. 21567

Date Dec. 17, 1996