

126102

REMONUMENTATION CORNER  
LAND CORNER RECORDATION CERTIFICATE  
Filing Requirement of Act 74, Mich. P.A. 1970

000206

For corners in  
ISABELLA

(County)

Located In:

Corner Code # 9700126102

1. Public Land Survey

T 13N R 4W

A-2

T 13N R 5W

M-2

T R

T R

2. Property Controlling  
in Section

S T R

S T R

3. Miscellaneous

S T R

Property in Sec.

S T R

Filed for Record in  
ISABELLA COUNTY, MI  
SHARON A BROWN  
On 11-25-1997 At 10:51:55 am.  
RE LAND COR 9.00  
Book OR Vol. 1 Pg. 206 - 206

Register of Deeds Stamp & File Number

4. Lot No. \_\_\_\_\_, Recorded Plat \_\_\_\_\_

5. Private Claims \_\_\_\_\_

	A	B	C	D	E	F	G	H	I	J	K	L
2	6		5		4		3		2		1	
3												
4	7		8		9		10		11		12	
5												
6	18		17		16		15		14		13	
7												
8	19		20		21		22		23		24	
9												
10	30		29		28		27		26		25	
11												
12	31		32		33		34		35		36	
13												

I, Wm. B Ruddell, in a field survey on December, 1994, do hereby certify that under requirements of P.A. 74, Michigan P.A. of 1970, the corner points mentioned in lines 1 and 2 above were in conformance with regulations and rules therefore as required in the current manual of survey instructions of the United States Department of the Interior, Bureau of Land Management or by a decree of a Court of Law and/or that the corner points mentioned in lines 3, 4 and 5 above were in conformance with the rules of the Michigan Board of Land Surveyors or by a Decree of a Court of Law; established, re-established, monumented, re-monumented, recovered, found as expressed below.

NOTE: Not more than 4 corners, all in the same town and range, may be recorded on this certificate.

A. Description of original monument and accessories and/or subsequent restoration:  
GLO Survey - Set Post for M-2 by John Hodgson - April, 1837

County Survey Records - Liber 1, Page 28 - No Surveyor or date given  
No material listed - Survey of Section 6, T13N-R4W

Liber 3, Page 163, Small Book 1, Page 60, 61 - same information  
Surveyor E. R. Coburn - Date April, 1901

Survey of Section 1, T13N-R5W, Stake, Stone and Plow Point

Road Commission Notes - 1" Iron Pipe - No Date


Private Surveys, LCRC's and Recorded Surveys dated 1971 to 1994 - 1" or 1 1/2" Iron Pipe.

B. Description of corner evidence found and/or method applied in restoring or reestablishing corner:

Held found 1 1/2" Iron Pipe which fits occupied roads to North, South and West and occupied fence line to East.

Fits all LCRC's and recorded surveys

Excavated and found no additional evidence.

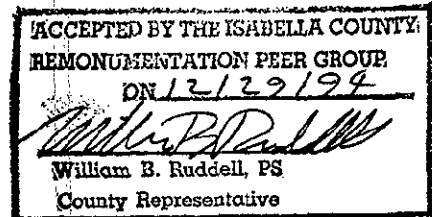


C. Description of monument for corner and accessories established to perpetuate locating the position of the corner:

Set standard County monument - marked A-2 and M-2

A-2 Witt: NE, 37.5', N&C in 20" Ash  
ENE, 25.07', N&C in 15" Ash  
ESE, 24.2', N&C in 12" Ash  
SW, 54.8', Top NE cor of Transform. Box

M-2 Witt:

SURVEY &  
REMONUMENTATION  
MAR 09 1998  
SECTION

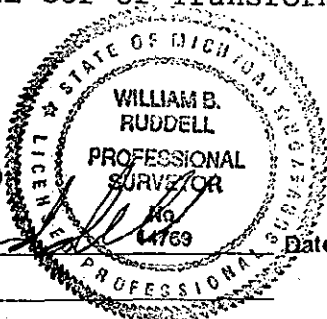

Signed by

Date November 15, 1995

Surveyor's Michigan License No. 14769