

98320 SURVEY & REMONUMENTATION
REMONUMENTATION CORNER

APR 27 1995 LAND CORNER RECORDATION CERTIFICATE
Filing Requirement of Act 74, Mich. P.A. 1970
COMMISSION

For corners in

ISABELLA
(County)

Located in:

Corner Code #

- | | | | | | |
|------------------------------------|---|-----|---|-----|-------|
| 1. Public Land Survey | T | 13N | R | R4W | A-4 |
| | T | 13N | R | R5W | M-4 ✓ |
| | T | | R | | |
| | T | | R | | |
| 2. Property Controlling in Section | S | | T | R | |
| | S | | T | R | |
| 3. Miscellaneous Property in Sec. | S | | T | R | |
| | S | | T | R | |

STATE OF MICHIGAN
COUNTY OF ISABELLA
RECEIVED FOR RECORD

MAR 23 12 PM '95

30
SHARON A. BROWN
REGISTER OF DEEDS

Register of Deeds Stamp & File Number

4. Lot No. _____, Recorded Plat _____
5. Private Claims _____

	A	B	C	D	E	F	G	H	I	J	K	L	M
2	6	5	4	3	2	1							
3													
4	7	8	9	10	11	12							
5													
6	18	17	16	15	14	13							
7													
8	19	20	21	22	23	24							
9													
10	30	29	28	27	26	25							
11													
12	31	32	33	34	35	36							
13													


I, Wm. B. Ruddell, in a field survey on November, 19 94, do hereby certify that under requirements of P.A. 74, Michigan P.A. of 1970, the corner points mentioned in lines 1 and 2 above were in conformance with regulations and rules therefore as required in the current manual of survey instructions of the United States Department of the Interior, Bureau of Land Management or by a decree of a Court of Law and/or that the corner points mentioned in lines 3, 4 and 5 above were in conformance with the rules of the Michigan Board of Land Surveyors or by a Decree of a Court of Law; established, re-established, monumented, re-monumented, recovered, found as expressed below:

NOTE: Not more than 4 corners, all in the same town and range, may be recorded on this certificate.

THIS IS A COMMON CORNER

A. Description of original monument and accessories and/or subsequent restoration:

- 1837 - Post
- 1977 - Found 3/4" Pipe
- 1991 - Found 3/4" Pipe - LCRC, Page 1102
- 1994 - Found 3/4" Pipe
- 1980 - Found 3/4" Pipe (LCRD, Page 621)

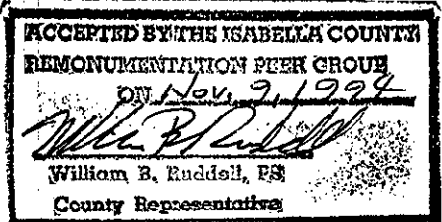

B. Description of corner evidence found and/or method applied in restoring or reestablishing corner:

- 1994 - Found 3/4" Pipe, excavated found 12" dia. stone along side of pipe, held 3/4" Pipe


And is accepted as a careful and faithful perpetuation fo the position of the original corner.

C. Description of monument for corner and accessories established to perpetuate locating the position of the corner:

- 1994 - Replaced 3/4" pipe with standard monument, marked M-4, A-4, in monument box, Set 5" ± below grade

Witnesses: NW, 48.38', N&C in Telephone Pole
NNE, 73.39', N&C in Fence Post
SSW, 61.94', N&C in Fence Post
WSW, 54.62', N&C in Fence Post

Signed by William B. Ruddell
Surveyor's Michigan License No. 14769

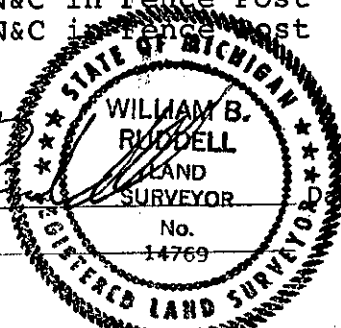

December 30, 1994