

1995-33 SURVEY & REMONUMENTATION COMMISSION APR 29 1996

REMONUMENTATION CORNER LAND CORNER RECORDATION CERTIFICATE Filing Requirement of Act 74, Mich. P.A. 1970

For Corners in Isabella Located In: Corner Code #
 (County)

1. Public Land Survey T 13N R 6W G-4
 T _____ R _____
 T _____ R _____
 T _____ R _____

2. Property Controlling S _____ T _____ R _____
 in Section S _____ T _____ R _____

3. Miscellaneous S _____ T _____ R _____
 Property in Sec. S _____ T _____ R _____

STATE OF MICHIGAN
 COUNTY OF ISABELLA
 RECEIVED FOR RECORD
 FEB 23 3 21 PM '96
 000087
 SHARON A. BROWN
 REGISTER OF DEEDS

Register of Deeds Stamp & File Number

4. Lot No. _____, Recorded Plat _____
 5. Private Claims _____

I, Gerald J. Gray, in a field survey on March 21, 1995, do hereby certify that under requirements of P.A. 74, Michigan P.A. of 1970, the corner points mentioned in lines 1 and 2 above were in conformance with regulations and rules therefore as required in the current manual of survey instructions of the United States Department of the Interior, Bureau of Land Management or by a decree of a Court of Law and/or that the corner points mentioned in lines 3, 4, and 5 above were in conformance with the rules of the Michigan Board of Land Surveyors or by a Decree of a Court of Law; established, re-established, monumented, re-monumented, recovered, found as expressed below:

	A	B	C	D	E	F	G	H	I	J	K	L	M
1													
2	6		5		4		3		2		1		
3													
4	7		8		9		10		11		12		
5													
6	18		17		16		15		14		13		
7													
8	19		20		21		22		23		24		
9													
10	30		29		28		27		26		25		
11													
12	31		32		33		34		35		36		
13													

Note: Not more than 4 corners, all in the same town and range, may be recorded on this certificate.

A. Description of original monument and accessories and/or subsequent restoration:

- Original G.L.O. Survey:
John Milroy D.S., north between section 9 & 10, set quarter section post, Nov. 17, 1837 - Dec. 4, 1837
- Joseph A. Graham found corner stone & broken delf, April 26 & 27
- L.C.R.C.
Gerald J. Gray, Filing Number 1220, July 12, 1993 Found stone by Joseph Graham
Gerald J. Gray, Filing Number 1220, July 12, 1993 Set iron on Section line at double distances north 1/8 and northwest section corner
- Unrecorded Survey by Gerald J. Gray, 5/30/92 Set 1/2" iron rod with cap on sec. line off occupied lines


B. Description of corner evidence found and/or method applied in restoring or reestablishing corner:
 Found 1/2" iron rod with cap on sec. line off occupied lines, Set standard Isabella County Monument in monument box

C. Description of monument for corner and accessories established to perpetuate locating the position of the corner:

- Standard Isabella County Monument in Monument Box
- 280° AZ 54.45' PK nail in power pole
 - 97° AZ 39.59' Nail & cap in 4" sugar maple
 - 138° AZ 46.73' 1/2" bar & cap
 - 85° AZ 44.88' PK nail in fence post
 - 274° AZ 87.82' Nail & cap in 12" sugar maple

ACCEPTED BY THE ISABELLA COUNTY
 REMONUMENTATION PEER GROUP
 ON Nov 8 1994
 William B. Ruddell, PS
 County Representative

Signed by Gerald J. Gray
 Surveyor's Michigan License No. 17741

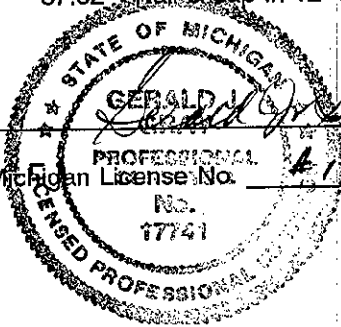

Date 1-24-96