

100577 SURVEY & REMONUMENTATION
 APR 29 1996
 COMMISSION

REMONUMENTATION CORNER
 LAND CORNER RECORDATION CERTIFICATE
 Filing Requirement of Act 74, Mich. P.A. 1970

STATE OF MICHIGAN
 COUNTY OF ISABELLA
 RECEIVED FOR RECORD

FEB 23 3 22 PM '96
 000091
 SHARON A. BROWN
 REGISTER OF DEEDS

For Corners in
Isabella
 (County)

Located In: Corner Code #

1. Public Land Survey T 13N R 6W H-3
 T _____ R _____
 T _____ R _____
 T _____ R _____

2. Property Controlling S _____ T _____ R _____
 in Section S _____ T _____ R _____

3. Miscellaneous S _____ T _____ R _____
 Property in Sec. S _____ T _____ R _____

4. Lot No. _____, Recorded Plat _____

5. Private Claims _____

Register of Deeds Stamp & File Number

I, Gerald J. Gray, in a field survey on March 20, 1995, do hereby certify that under requirements of P.A. 74, Michigan P.A. of 1970, the corner points mentioned in lines 1 and 2 above were in conformance with regulations and rules therefore as required in the current manual of survey instructions of the United States Department of the Interior, Bureau of Land Management or by a decree of a Court of Law and/or that the corner points mentioned in lines 3, 4, and 5 above were in conformance with the rules of the Michigan Board of Land Surveyors or by a Decree of a Court of Law; established, re-established, monumented, re-monumented, recovered, found as expressed below:

	A	B	C	D	E	F	G	H	I	J	K	L	M
1													
2	6		5		4		3		2		1		
3													
4	7		8		9		10		11		12		
5													
6	18		17		16		15		14		13		
7													
8	19		20		21		22		23		24		
9													
10	30		29		28		27		26		25		
11													
12	31		32		33		34		35		36		
13													

Note: Not more than 4 corners, all in the same town and range, may be recorded on this certificate.


- A. Description of original monument and accessories and/or subsequent restoration:
1. Original G.L.O. Survey:
 John Milroy D.S., Nov. 17, 1837 - Dec. 4, 1837, west corrected between section 3 & 10, set quarter section post
 2. Joseph A. Graham set hem stake equidistant, April 26 & 27

B. Description of corner evidence found and/or method applied in restoring or reestablishing corner:

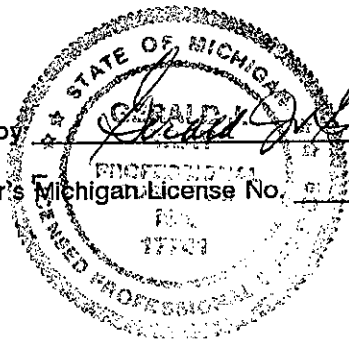
Found 1/2" x 30" pipe next to remains of wood stake & surrounded by stones, Set standard Isabella County Monument in monument box

C. Description of monument for corner and accessories established to perpetuate locating the position of the corner:

- Standard Isabella County Monument in Monument box
- 34° AZ 37.54' Nail & cap in power pole
 - 48° AZ 63.67' Nail & cap in 4" red pine
 - 261° AZ 131.12' Nail & cap in power pole
 - 144° AZ 16.68' 1/2" re-rod

ACCEPTED BY THE ISABELLA COUNTY
 REMONUMENTATION PEER GROUP
 ON Nov. 5, 1998

 William B. Ruddell, PS
 County Representative

Signed by Gerald J. Gray
 Surveyor's Michigan License No. #17741



Date 1-24-96