

SURVEY & REMONUMENTATION COMMISSION
 APR 29 1996

**REMONUMENTATION CORNER
 LAND CORNER RECORDATION CERTIFICATE**
 Filing Requirement of Act 74, Mich. P.A. 1970

STATE OF MICHIGAN
 COUNTY OF ISABELLA
 RECEIVED FOR RECORD
 FEB 23 3 22 PM '96
 000092
 SHARON A. BROWN
 REGISTER OF DEEDS

For Corners in Isabella Located In: Corner Code #
 (County)

1. Public Land Survey	T <u>13N</u> R <u>6W</u>	<u>I-4</u>
	T _____ R _____	_____
	T _____ R _____	_____
	T _____ R _____	_____
2. Property Controlling in Section	S _____ T _____ R _____	_____
	S _____ T _____ R _____	_____
3. Miscellaneous Property in Sec.	S _____ T _____ R _____	_____
	S _____ T _____ R _____	_____

Register of Deeds Stamp & File Number

4. Lot No. _____, Recorded Plat _____
 5. Private Claims _____

I, Gerald J. Gray, in a field survey on March 20, 1995, do hereby certify that under requirements of P.A. 74, Michigan P.A. of 1970, the corner points mentioned in lines 1 and 2 above were in conformance with regulations and rules therefore as required in the current manual of survey instructions of the United States Department of the Interior, Bureau of Land Management or by a decree of a Court of Law and/or that the corner points mentioned in lines 3, 4, and 5 above were in conformance with the rules of the Michigan Board of Land Surveyors or by a Decree of a Court of Law; established, re-established, monumented, re-monumented, recovered, found as expressed below:

	A	B	C	D	E	F	G	H	I	J	K	L	M
1													
2	6		5		4		3		2		1		
3													
4	7		8		9		10		11		12		
5													
6	18		17		16		15		14		13		
7													
8	19		20		21		22		23		24		
9													
10	30		29		28		27		26		25		
11													
12	31		32		33		34		35		36		
13													

Note: Not more than 4 corners, all in the same town and range, may be recorded on this certificate.

A. Description of original monument and accessories and/or subsequent restoration:

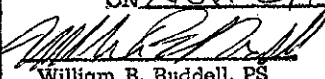
- Original G.L.O. Survey:
 John Milroy D.S., Nov. 17, 1837 - Dec. 4, 1837, north between section 10 & 11, set quarter section post
- Joseph A. Graham, April 26 & 27, found stake set by A.R. Arnold
- E.R. Coburn, 1887, found stake set by A.R. Arnold
- L.C.R.C.
 William B. Ruddell, Filing No. 535, 9/13/73 Found rotten stake under large green stone - reset 3/4" pipe
 Gerald J. Gray, 3/91 Found 3/4" pipe
- Survey of Record
 L. 003, P. 315, William B. Ruddell, 9/13/73 Found rotten wood stake & crockery under large green stone, set 3/4" pipe over top of stake
 L. 003, P. 652, William B. Ruddell, 12/31/81 Survey marker not noted
- Unrecorded Survey, Thomas J. Mueller, 11/20/85 Found 3/4" rod
- Unrecorded Surveys for the Andersen Brothers, Gerald J. Gray, 4/10/91 - 4/15/91 Found 3/4" pipe

B. Description of corner evidence found and/or method applied in restoring or reestablishing corner:

Found 3/4" pipe, Set Standard Isabella County Monument in Monument Box

C. Description of monument for corner and accessories established to perpetuate locating the position of the corner:

- Standard Isabella County Monument in Monument Box
- 65° AZ 77.78' Scaffold nail in power pole
 - 155° AZ 63.68' Nail & cap in 4" black cherry
 - 273° AZ 18.02' "X" on top south end of 12" CMP
 - 343° AZ 62.77' Southeast corner of telephone cable box
 - 287° AZ 209.22' Power pole

ACCEPTED BY THE ISABELLA COUNTY
 REMONUMENTATION PEER GROUP
 ON Nov. 8, 1994

 William B. Ruddell, PS
 County Representative

Signed by _____ Date 1-24-96

Surveyor's Michigan License No. 17741

