

MAR 09 1999

133-10

LAND CORNER RECORDATION CERTIFICATE
Filing Requirement of Act 74, Mich. P.A. 1970
Isabella County Remonumentation

SECTION

For corners in

Isabella (County) Located In: Corner Code #
1. Public Land Survey T 13N R 6W I-6
2. Property Controlling in Section S T R
3. Miscellaneous Property in Sec. S T R
4. Lot No. Recorded Plat
5. Private Claims

9800013340
Filed for Record in
ISABELLA COUNTY, MI
SHARON A BROWN
On 12-30-1998 At 10:28:20 am.
RE LAND COR 9.00
OR Liber 1 Page 257 - 257


Register of Deeds Stamp & File Number

Grid table with columns A-M and rows 2-13. Cell I-14 contains a black dot.

I, Timothy E Bebee, in a field survey on December 1, 1998, do hereby state that under requirements of P.A. 74, Michigan P.A. of 1970, the corner points mentioned in lines 1 and 2 above were in conformance with regulations and rules therefore as required in the current manual of survey instructions of the United States Department of the Interior, Bureau of Land Management or by a decree of a Court of Law and/or that the corner points mentioned in lines 3, 4 and 5 above were in conformance with the rules of the Michigan Board of Land Surveyors or by a Decree of a Court of Law; established, re-established, monumented, recovered, found as expressed below:

NOTE: Not more than 2 corners, all in the same town and range, may be recorded on this certificate.

- A. Description of original monument and accessories and/or subsequent restoration:
1837 J. Milroy GLO.....set post
1882 J. Graham CS.....set swamp oak stake 4x4
1973 A. Courtright LCRC 151.....found 1/2" x 18" steel rod in road
1973 J. Jones PA 132.....found 3/4" iron pipe(L001,P406)
1977 J. Jones PA 132.....found 3/4" iron pipe(L003,P16)
1980 T. Mueller LCRC 639.....found 3/4" rod
1980 T. Mueller PA 132.....found 3/4" Iron (L003,P515)
1985 T. Mueller unrecorded survey.....found 3/4" rod as recorded book 2 page 639
1986 W. Ruddell LCRC 817.....found 3/4" pipe

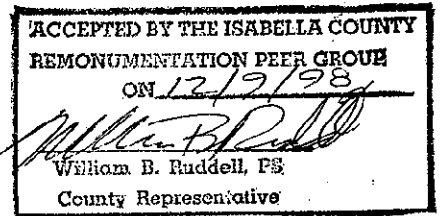

B. Description of corner evidence found and/or method applied in restoring or reestablishing corner:
Found 3/4" iron pipe 2'± East of the centerline of Brinton Rd. and 10'± south of centerline of trail West. Also found 1/2" iron 2'± West and 3'± South of 3/4" iron pipe. Excavated below both irons found no other evidence and no metallic readings. Accepted the 3/4" iron pipe as the best available evidence of the perpetuated corner due to the use of this corner in previously recorded surveys and based on recommendation of the peer group.

C. Description of monument for corner and accessories established to perpetuate locating the position of the corner:
A Remonumentation monument stamped #39074, placed inside a monument box, was set at the position of the Corner and is accepted as the best available evidence of the perpetuated corner.

Witnesses:

- S 75° E 34.36' nail & cap in 6" pine
S 46° W 66.24' nail & cap in 10" polar
N 86° W 33.67' nail in fence post
N 40° W 47.85' face of a 2" iron pipe fence corner post in concrete



Signed by Timothy E Bebee Date 12/29/98
Surveyor's Michigan License No. 39074