

1985-12 SURVEY & REMONUMENTATION COMMISSION APR 29 1996

REMONUMENTATION CORNER LAND CORNER RECORDATION CERTIFICATE Filing Requirement of Act 74, Mich. P.A. 1970

For Corners in Isabella (County) Located In: _____ Corner Code # _____

1. Public Land Survey	T <u>13N</u> R <u>6W</u>	<u>J-3</u>
	T _____ R _____	_____
	T _____ R _____	_____
	T _____ R _____	_____
2. Property Controlling in Section	S _____ T _____ R _____	_____
	S _____ T _____ R _____	_____
3. Miscellaneous Property in Sec.	S _____ T _____ R _____	_____
	S _____ T _____ R _____	_____

STATE OF MICHIGAN COUNTY OF ISABELLA RECEIVED FOR RECORD FEB 23 22 PM '96 000096 SHARON A. BROWN REGISTER OF DEEDS

Register of Deeds Stamp & File Number

4. Lot No. _____, Recorded Plat _____
5. Private Claims _____

I, Gerald J. Gray, in a field survey on March 20, 1995, do hereby certify that under requirements of P.A. 74, Michigan P.A. of 1970, the corner points mentioned in lines 1 and 2 above were in conformance with regulations and rules therefore as required in the current manual of survey instructions of the United States Department of the Interior, Bureau of Land Management or by a decree of a Court of Law and/or that the corner points mentioned in lines 3, 4, and 5 above were in conformance with the rules of the Michigan Board of Land Surveyors or by a Decree of a Court of Law; established, re-established, monumented, re-monumented, recovered, found as expressed below:

	A	B	C	D	E	F	G	H	I	J	K	L	M
1													
2	6			5			4			3		2	1
3													
4	7			8			9			10		11	12
5													
6	18			17			16			15		14	13
7													
8	19			20			21			22		23	24
9													
10	30			29			28			27		26	25
11													
12	31			32			33			34		35	36
13													

Note: Not more than 4 corners, all in the same town and range, may be recorded on this certificate.

A. Description of original monument and accessories and/or subsequent restoration:

- Original G.L.O. Survey: John Milroy D.S., Nov. 17, 1837 - Dec. 4, 1837, west corrected between section 2 & 11, set quarter section post
- E. R. Coburn, Moore, Roberts, Chapman, 1887, set pine stake 4 x 4
- E. R. Coburn, 1901, Old corner and BT gone, set stake equidistant between I & N
- L.C.R.C.
- Gerald J. Gray, 3/91 Set R.R. spike on Sec. line, 4.5'± north of centerline, equidistant
- Unrecorded Survey by Gerald J. Gray, 3/14/91 Set R.R. spike on Sec. line, 4.5'± north of centerline equidistant
- Unrecorded Survey by Gerald J. Gray, 4/10/91 Set R.R. spike on Sec. line, 4.5'± north of centerline equidistant
- Unrecorded Survey by Gerald J. Gray, 8/17/93 Found railroad spike

B. Description of corner evidence found and/or method applied in restoring or reestablishing corner:


Found railroad spike, Set standard Isabella County Monument in monument box

C. Description of monument for corner and accessories established to perpetuate locating the position of the corner:

- Standard Isabella County Monument in Monument Box
- 115° AZ 61.77' 4" white birch
 - 179° AZ 29.37' 4" black cherry
 - 245° AZ 58.39' 4" white oak
 - 70° AZ 25.15' 4" elm
 - 180° AZ 6'± Centerline gravel road (E-W)

ACCEPTED BY THE ISABELLA COUNTY REMONUMENTATION PEER GROUP ON NOV 8, 1994 William B. Ruddell, PS County Representative

Signed by Gerald J. Gray Surveyor's Michigan License No. #17741

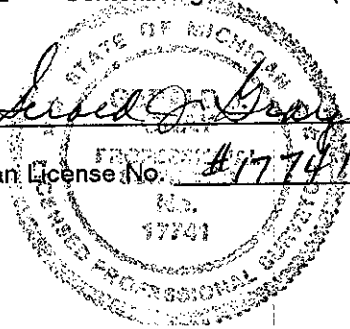

Date 1-24-96