

JAN 25 2000

12915

REMONUMENTATION CORNER
LAND CORNER RECORDATION CERTIFICATE
Filing Requirement of Act 74, Mich. P.A. 1970

SECTION

000343

For corners in

<u>Isabella</u> (County)	Located In:	Corner Code #
1. Public Land Survey	T <u>13N</u> R <u>6W</u> <u>K-1</u>	
	T _____ R _____	
	T _____ R _____	
	T _____ R _____	
2. Property Controlling in Section	S _____ T _____ R _____	
	S _____ T _____ R _____	
3. Miscellaneous Property in Sec.	S _____ T _____ R _____	
	S _____ T _____ R _____	

199900012915
 Filed for Record in
 ISABELLA COUNTY, MI
 SHARON A BROWN
 On 12-29-1999 At 09:36:20 am.
 RE LAND COR 9.00
 Liber 1 Page 343 - 343

Register of Deeds Stamp & File Number

4. Lot No. _____, Recorded Plat _____
 5. Private Claims _____


I, Ronald R. Harris, P.S., in a field survey on November 24, 19 99, do hereby certify that under requirements of P.A. 74, Michigan P.A. of 1970, the corner points mentioned in lines 1 and 2 above were in conformance with regulations and rules therefore as required in the current manual of survey instructions of the United States Department of the Interior, Bureau of Land Management or by a decree of a Court of Law and/or that the corner points mentioned in lines 3, 4 and 5 above were in conformance with the rules of the Michigan Board of Land Surveyors or by a Decree of a Court of Law; established, re-established, monumented, re-monumented, recovered, found as expressed below:

NOTE: Not more than 2 corners, all in the same town and range, may be recorded on this certificate.

	A	B	C	D	E	F	G	H	I	J	K	L	M
1													
2		6		5		4		3		2		1	
3													
4		7		8		9		10		11		12	
5													
6		18		17		16		15		14		13	
7													
8		19		20		21		22		23		24	
9													
10		30		29		28		27		26		25	
11													
12		31		32		33		34		35		36	
13													

A. Description of original monument and accessories and/or subsequent restoration:

1837 Milny GLO.....set post 1.34ch. West of corner common to sections 35 and 36, T14N-R6W
 1882 Graham C.S.....set 2X2 pine post
 1897 Trussel C.S.....set stone from O.B.T.
 1897 Trussel C.S.....stone 10" for corner (SE cor. Sec.35 T14N-R6W)
 1901 Coburn C.S.....stone 12" at corner
 1972 William B. Ruddell P.A. 132.....found 3/4" pipe
 1976 Jerry L. Jones P.A. 132.....found 'T' iron
 1984 Herbert L. Fluharty LCRC.....found 'T' iron
 1985 Herbert L. Fluharty P.A. 132.....found 'T' iron
 1986 Jan S. Folkens P.A.132.....found 'T' iron
 1997 ICRC.....found 'T' iron
 1998 Ronald R. Harris P.A. 132.....found 5/8" rod in monument box

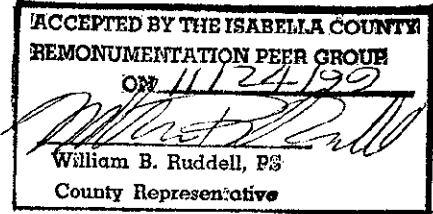

B. Description of corner evidence found and/or method applied in restoring or reestablishing corner:

November 1999: Found 5/8" x 1.1' rebar in monument box. At a depth of 12"± found bent T-iron. Excavated to a depth of 4.5', found no other evidence of existing corner.
 This is an existent corner.


C. Description of monument for corner and accessories established to perpetuate locating the position of the corner:

A Remonumentation monument stamped #41917, placed inside a monument box, was set at the position of the found 'T' iron where straight and is accepted as the best available evidence of the perpetuated corner.

WITNESSES

N50°W 62.25' Found Nail and Disc West Face P-Pole.
 S45°W 73.70' Nail and Flagging in Wood Post.
 S60°E 81.50' Northeast Corner of Concrete Marker Post.
 East 88.44' Remon Corner in Monument Box, Southwest Corner Section 36, T14N-R6W, Broomfield Township.

Signed by ROBA
 Surveyor's Michigan License No. 41917

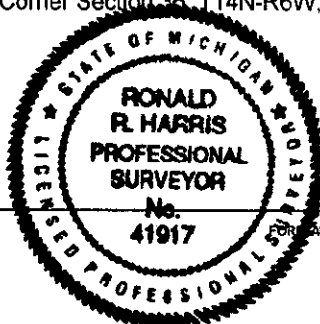

Date 12/02/99