

JAN 25 2000

12917

REMONUMENTATION CORNER
LAND CORNER RECORDATION CERTIFICATE
Filing Requirement of Act 74, Mich. P.A. 1970

SECTION

000345

For corners in

199900012917
Filed for Record in
ISABELLA COUNTY, MI
SHARON A BROWN
On 12-29-1999 At 09:36:28 am.
RE LAND COR 9.00
Liber 1 Page 345 - 345

Register of Deeds Stamp & File Number

<u>Isabella</u> (County)	Located In:	Corner Code #
1. Public Land Survey	T <u>13N</u> R <u>6W</u> L- <u>1</u>	
	T _____ R _____	
	T _____ R _____	
	T _____ R _____	
2. Property Controlling in Section	S _____ T _____ R _____	
	S _____ T _____ R _____	
3. Miscellaneous Property in Sec.	S _____ T _____ R _____	
	S _____ T _____ R _____	

4. Lot No. _____, Recorded Plat _____
5. Private Claims _____

I, Ronald R. Harris, P.S., in a field survey on November 24, 1999, do hereby certify that under requirements of P.A. 74, Michigan P.A. of 1970, the corner points mentioned in lines 1 and 2 above were in conformance with regulations and rules therefore as required in the current manual of survey instructions of the United States Department of the Interior, Bureau of Land Management or by a decree of a Court of Law and/or that the corner points mentioned in lines 3, 4 and 5 above were in conformance with the rules of the Michigan Board of Land Surveyors or by a Decree of a Court of Law, established, re-established, monumented, re-monumented, recovered, found as expressed below:

	A	B	C	D	E	F	G	H	I	J	K	L	M
1													
2	6	5	4	3	2	1							
3													
4	7	8	9	10	11	12							
5													
6	18	17	16	15	14	13							
7													
8	19	20	21	22	23	24							
9													
10	30	29	28	27	26	25							
11													
12	31	32	33	34	35	36							
13													

NOTE: Not more than 2 corners, all in the same town and range, may be recorded on this certificate.

A. Description of original monument and accessories and/or subsequent restoration:

1882 Graham.....set white Oak stake equidistant
1972 William B. Ruddell P.A. 132.....found 3/4" pipe
1984 Herbert L. Fluharty P.A. 132.....found 3/4" pipe
1998 Ronald R. Harris P.A. 132.....found capped iron (#17741)

B. Description of corner evidence found and/or method applied in restoring or reestablishing corner:

November 1999: Found Capped Iron at road grade, unable to read cap. Found 3/4" x 18" pipe at a depth of 1.5'. Excavated to a depth of 4.3', did not find stone as recorded in May, 1972. Found no other evidence of corner.
This is an existent corner.

C. Description of monument for corner and accessories established to perpetuate locating the position of the corner:


A Remonumentation monument stamped #41917, placed inside a monument box, was set at the position of the found capped iron and is accepted as the best available evidence of the perpetuated corner.

WITNESSES

East 47.41' Found Capped Iron, South 1/4 Corner Section 36, T14N-R6W, Broomfield Township
NNE 45.30' Found Nail and Flagging 8" Poplar.
South 40.55' Found Nail and Flagging 8" Tree.
S10°W 98.45' Found East End Top Center 12" CMP.

Distances:

L-1 to M-1.....2687.73'
L-1 to K-1.....2682.51'

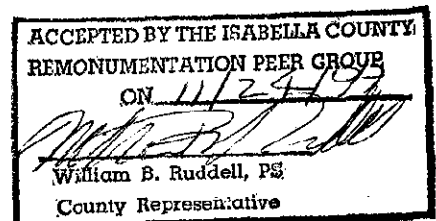

Signed by RORR
Surveyor's Michigan License No. 41917

Date 12/02/99