

APR 27 1995

**REMONUMENTATION CORNER**

98514 COMMISSION

**LAND CORNER RECORDATION CERTIFICATE**  
**Filing Requirement of Act 74, Mich. P.A. 1970**

For corners in

ISABELLA  
 (County)

Located In:

Corner Code #

- 1. Public Land Survey      T 14N R 3W      A-7
- T \_\_\_\_\_ R \_\_\_\_\_
- T \_\_\_\_\_ R \_\_\_\_\_
- T \_\_\_\_\_ R \_\_\_\_\_
- 2. Property Controlling    S \_\_\_\_\_ T \_\_\_\_\_ R \_\_\_\_\_
- in Section               S \_\_\_\_\_ T \_\_\_\_\_ R \_\_\_\_\_
- 3. Miscellaneous           S \_\_\_\_\_ T \_\_\_\_\_ R \_\_\_\_\_
- Property in Sec.         S \_\_\_\_\_ T \_\_\_\_\_ R \_\_\_\_\_

- 4. Lot No. \_\_\_\_\_, Recorded Plat \_\_\_\_\_
- 5. Private Claims \_\_\_\_\_

STATE OF MICHIGAN  
 COUNTY OF ISABELLA  
 RECEIVED FOR RECORD

MAR 13 2 21 PM '95  
 000052

SHARON A. BROWN  
 REGISTER OF DEEDS

Register of Deeds Stamp & File Number


	A	B	C	D	E	F	G	H	I	J	K	L	M
2	6		5		4		3		2		1		
3													
4	7		8		9		10		11		12		
5													
6	18		17		16		15		14		13		
7													
8	19		20		21		22		23		24		
9													
10	30		29		28		27		26		25		
11													
12	31		32		33		34		35		36		
13													

I, Wm. B. Ruddell, in a field survey on November, 1994, do hereby certify that under requirements of P.A. 74, Michigan P.A. of 1970, the corner points mentioned in lines 1 and 2 above were in conformance with regulations and rules therefore as required in the current manual of survey instructions of the United States Department of the Interior, Bureau of Land Management or by a decree of a Court of Law and/or that the corner points mentioned in lines 3, 4 and 5 above were in conformance with the rules of the Michigan Board of Land Surveyors or by a Decree of a Court of Law; established, re-established, monumented, re-monumented, recovered, found as expressed below:

**NOTE: Not more than 4 corners, all in the same town and range, may be recorded on this certificate.**

A. Description of original monument and accessories and/or subsequent restoration:

- 1832 - Post
- 1910 - Fnd: 1 1/2"x48" Gas Pipe
- 1971 - Fnd: 5/8" x 18" Rod - LCRC 275
- 1973 - Fnd: 5/8" Solid Rod - LCRC 183
- 1975 - Fnd: 5/8" Solid Rod
- 1980 - Fnd: 5/8" Solid Rod - LCRC 598
- 1981 - Fnd: Iron
- 1988 - Fnd: 5/8" Solid Rod
- 1992 - Fnd: Capped "T" in Mon. box - LCRC 1179
- 1993 - Fnd: Capped "T" in Mon Box - LCRC 1240

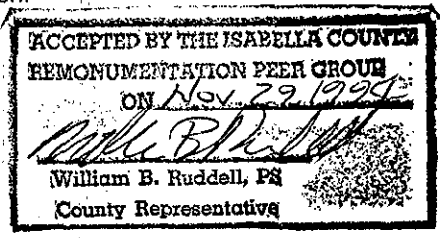

B. Description of corner evidence found and/or method applied in restoring or reestablishing corner:

1994 - Found "T" in monument box, witnessed and removed augered down at 2' below existing grade - hit top of 5/8" solid rod, checks "T" iron, continued down East side of rod to depth of 3.7' (NAT ground) Hit nothing else, Reset "T" in existing monument box.  
 Distance between corners A-7 T14N-R3W to M-7 T14N-R4W  
 Original Survey - South, 134 links = 88.44 feet  
 Survey - 1910 - South, 99 links = 65.34 feet  
 Survey - 1994 - South 61.67 feet


And is accepted as a careful and faithful perpetuation of the position of the original corner.

C. Description of monument for corner and accessories established to perpetuate locating the position of the corner:

1994 - Removed "T" iron and replaced with standard monument marked A-7

Witnesses: NW, 70.01', N&C in Power Pole  
 SSW, 38.43', Chiseled "x" on N. end 24" CMP  
 S, 61.67', SE cor. Sec. 13, T14N-R4W  
 SSE, 89.21', Chiseled "x" on 18" CMP + FROM E. End

Signed by William B. Ruddell  
 Surveyor's Michigan License No. 14769

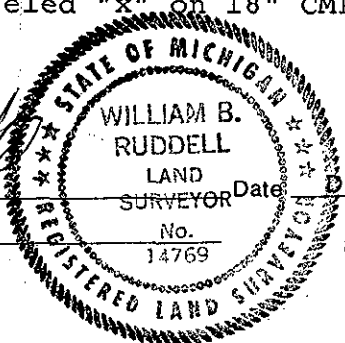

Date December 10, 1994