

SURVEY & REMONUMENTATION
 852-13
 MAR 16 1994

STATE OF MICHIGAN
 COUNTY OF ISABELLA
 REGISTER OF DEEDS

Nov 30 11 31 AM '93
 000002
 Helene L. Gilmore
 REGISTER OF DEEDS

COMMISSION LAND CORNER RECORDATION CERTIFICATE
 Filing Requirement of Act 74, Mich. P.A. 1970

For corners in Isabella (County)

	Located In:		Corner Code #
	14N	3W	
1. Public Land Survey	T	R	A-6, B
	T	R	
	T	R	
	T	R	
2. Property Controlling in Section	S	T	R
	S	T	R
3. Miscellaneous Property in Sec.	S	T	R
	S	T	R

4. Lot No. _____, Recorded Plat _____
 5. Private Claims _____

Register of Deeds Stamp & File Number

I, Norman C. Caldwell, in a field survey on July, 1993, do hereby certify that under requirements of P.A. 74, Michigan P.A. of 1970, the corner points mentioned in lines 1 and 2 above were in conformance with regulations and rules therefore as required in the current manual of survey instructions of the United States Department of the Interior, Bureau of Land Management or by a decree of a Court of Law and/or that the corner points mentioned in lines 3, 4 and 5 above were in conformance with the rules of the Michigan Board of Land Surveyors or by a Decree of a Court of Law; established, re-established, monumented, re-monumented, recovered, found as expressed below:


A	B	C	D	E	F	G	H	I	J	K	L	M
2	6	5	4	3	2	1						
3												
4	●	8	9	10	11	12						
5												
6	●	18	17	16	15	14	13					
7												
8	19	20	21	22	23	24						
9												
10	30	29	28	27	26	25						
11												
12	31	32	33	34	35	36						
13												

NOTE: Not more than 4 corners, all in the same town and range, may be recorded on this certificate.

A. Description of original monument and accessories and/or subsequent restoration:

(A-6) West 1/4 Cor. Sec. 18, T14N-R3W
 This position not established by original government survey.
 L.C.R.C. by W. Ruddell, Recorded in Bk.1 P.187, Found 39mm Iron Pipe: NW 8.23M T. Pole; NE 22.34M 45.5cm Tree; North 23.256M M-6, T14N-R4W
 L.C.R.C. by J. Radcliffe, Recorded in Bk. 1 P.275, Found 39mm Pipe 30.5cm deep, Placed 16mm x 45.5cm Rod in Center of Pipe: S85°E 9.833M Fnc Post; West 8.202M P. Pole; N50°E 16.752M 25.5cm Willow.
 L.C.R.C. by W. Ruddell, Recorded in Bk. 2 P.508, Found Iron Pipe: NW 8.23M T. Pole; NE 22.342M 45.5cm Tree.
 Survey by: Ruddell L.1 P.516 & Co. Surv. record book 4 P. 98

(B-4) Center 1/4 Cor. Sec. 7, T14N-R3W
 This position not established by original government survey.
 L.C.R.C. by W. Ruddell, Recorded in Bk.2 P.587, Found 20mm Pipe: WSW 16.86M 25.5cm Ash; SE 10.21M 20cm Apple; ENE 25.039M 30.5cm Oak.
 Surveys by: Ruddell L.3 P.378, Fokens L.1 P.299 County Surveyors book 3, P.72

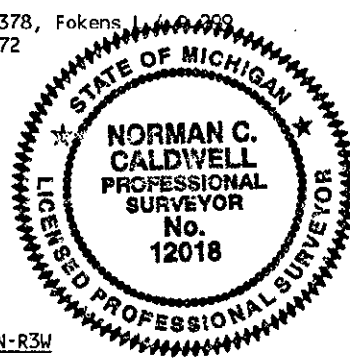

B. Description of corner evidence found and/or method applied in restoring or reestablishing corner:

(A-6) West 1/4 Cor, Sec. 18, T14N-R3W
 Found Tee Iron in Mon. Box (Origin Unknown)

(B-4) Center 1/4 Cor. Sec. 7, T14N-R3W
 Found 20mm Iron Pipe per Bk. 2 P. 587,

C. Description of monument for corner and accessories established to perpetuate locating the position of the corner:

(A-6) West 1/4 cor. Sec. 18, T14N-R3W
 Fnd Tee iron in Mon. Box, origin unknown, and is accepted as a careful and faithful determination of the position of the corner.
 S87°W 8.465M T. Pole
 N74°E 34.792M 45.5cm Maple
 N37°E 22.285M 76 cm Willow
 N44°W 11.000M Top of guy anchor
 South 23.272M 52mm Iron pipe in Mon. box (R) (E 1/4 Sec. 13, T14N-R4W)

(B-4) Center 1/4 Cor. Sec. 7, T14N-R3W
 Fnd 20mm iron pipe per Bk. 2 P.587 and is accepted as a careful and faithful determination of the position of the corner.
 N81°E 25.040M 30.5cm B. Oak
 S55°E 33.300M 18cm Boxelder
 S05°W 11.670M 13cm B. Oak
 N20°E 11.164M 15cm Elm

Signed by Norman C. Caldwell
 Surveyor's Michigan License No. 12018

Date 26 Nov 93