

**SURVEY &
REMONUMENTATION**

APR 29 1996

COMMISSION

**REMONUMENTATION CORNER
LAND CORNER RECORDATION CERTIFICATE
Filing Requirement of Act 74, Mich. P.A. 1970**

STATE OF MICHIGAN
COUNTY OF ISABELLA
RECEIVED FOR RECORD

DEC 11 10 37 AM '95
000074
SHARON A. BROWN
REGISTER OF DEEDS

Register of Deeds Stamp & File Number

For corners in
ISABELLA
(County)

Located In: _____ Corner Code # _____

- | | | |
|---------------------------------------|--------------------------|------------|
| 1. Public Land Survey | T <u>14N</u> R <u>3W</u> | <u>C-8</u> |
| | T _____ R _____ | _____ |
| | T _____ R _____ | _____ |
| | T _____ R _____ | _____ |
| 2. Property Controlling in Section | S _____ T _____ R _____ | _____ |
| | S _____ T _____ R _____ | _____ |
| 3. Miscellaneous Property in Sec. | S _____ T _____ R _____ | _____ |
| | S _____ T _____ R _____ | _____ |
| 4. Lot No. _____, Recorded Plat _____ | | |
| 5. Private Claims _____ | | |

	A	B	C	D	E	F	G	H	I	J	K	L	M
2	6		5		4		3		2		1		
3													
4	7		8		9		10		11		12		
5													
6	18		17		16		15		14		13		
7													
8	19		20		21		22		23		24		
9													
10	30		29		28		27		26		25		
11													
12	31		32		33		34		35		36		
13													

I, Wm. B. Ruddell, in a field survey on November, 1994, do hereby certify that under requirements of P.A. 74, Michigan P.A. of 1970, the corner points mentioned in lines 1 and 2 above were in conformance with regulations and rules therefore as required in the current manual of survey instructions of the United States Department of the Interior, Bureau of Land Management or by a decree of a Court of Law and/or that the corner points mentioned in lines 3, 4 and 5 above were in conformance with the rules of the Michigan Board of Land Surveyors or by a Decree of a Court of Law; established, re-established, monumented, re-monumented, recovered, found as expressed below:

NOTE: Not more than 4 corners, all in the same town and range, may be recorded on this certificate.


A. Description of original monument and accessories and/or subsequent restoration:

- 1832 - Post
- 1873 - Stake (also gas pipe no name or date)
- 1887 - Furnace grates
- 1972 - Found furnace grates
- 1977 - Set RR Spike from Witnesses
- 1980 - Found RR Spike
- 1983 - Found RR Spike
- 1985 - Found RR Spike
- 1989 - Found 1" Pipe in Mon. Box
- 1990 - Found 1" Pipe in Mon Box
- 1991 - Found 1" Pipe in Mon Box
- 1992 - Found 1' Pipe in Mon Box
- 1993 - Found 1" Pipe in Mon Box
- 1994 - Found 1' Pipe in Mon Box

B. Description of corner evidence found and/or method applied in restoring or reestablishing corner:

Found 1" Pipe in monument box verified location by two witnesses from 1972

And is accepted as a careful and faithful perpetuation of the position of the original corner.

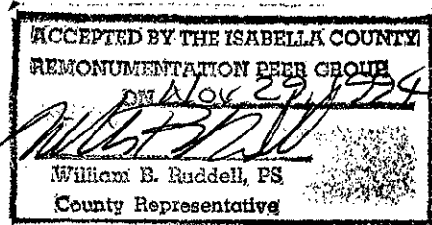

C. Description of monument for corner and accessories established to perpetuate locating the position of the corner:

- Set standard County monument - marked C-8
- Witnesses: NW, 116.5', SE corner 1st House
- NW, 71.15', Centerline Telephone Cable Box
- NE, 67.05', Centerline Telephone Cable Box
- SW, 44.11', "PK" Nail in cutoff Telephone Pole (1972 witness)
- SE, 51.03', Head of spike in 10" Tree



Signed by [Signature]

Date December 10, 1994

Surveyor's Michigan License No. 14769