

85250

MAR 16 1994

STATE OF MICHIGAN  
COUNTY OF ISABELLA  
RECEIVED

Nov 30 11 32 AM '93  
000009

*Richard L. Blumore*  
REGISTER OF DEEDS

COMMISSIONER LAND CORNER RECORDATION CERTIFICATE  
Filing Requirement of Act 74, Mich. P.A. 1970

For corners in  
Isabella  
(County)

	Located In:		REMONUMENTATION
	14N	3W	Corner Code ##
1. Public Land Survey	T _____	R _____	F-5/F-6
	T _____	R _____	
	T _____	R _____	
	T _____	R _____	
2. Property Controlling in Section	S _____	R _____	
	S _____	R _____	
3. Miscellaneous Property in Sec.	S _____	R _____	
	S _____	R _____	
4. Lot No. _____, Recorded Plat _____			
5. Private Claims _____			

Register of Deeds Stamp & File Number

I, Norman C. Caldwell, in a field survey on July, 1993, do hereby certify that under requirements of P.A. 74, Michigan P.A. of 1970, the corner points mentioned in lines 1 and 2 above were in conformance with regulations and rules therefore as required in the current manual of survey instructions of the United States Department of the Interior, Bureau of Land Management or by a decree of a Court of Law and/or that the corner points mentioned in lines 3, 4 and 5 above were in conformance with the rules of the Michigan Board of Land Surveyors or by a Decree of a Court of Law; established, re-established, monumented, re-monumented, recovered, found as expressed below:

NOTE: Not more than 4 corners, all in the same town and range, may be recorded on this certificate.

A	B	C	D	E	F	G	H	I	J	K	L	M
2	6	5	4	3	2	1						
3												
4	7	8	9	10	11	12						
5												
6	16	17	18	15	14	13						
7												
8	19	20	21	22	23	24						
9												
10	30	29	28	27	26	25						
11												
12	31	32	33	34	35	36						
13												

A. Description of original monument and accessories and/or subsequent restoration:

(F-5) 1/4 Cor., Sec. 9 & 16, T14N-R3W

Wood post placed by Joel Whight in 1832 Sub. of Twp.: N39°E 14 L.(2.816M) 16" (40.5cm) Pine; S23°W 8 L. (1.609M) 6" (15cm) Hemlock.

L.C.R.C. by P.Lapham, Recorded in Bk. 1 P.295, Found 26mm Iron Bar:

L.C.R.C. by D. Whittier, Recorded in Bk.1 P.315, Found 26mm Shaft:

L.C.R.C. by H. Fluharty, Recorded in Bk. 1 P.369, Found 26mm Bar, 11.03M South of M-20 @ Gravel Rd to North:

L.C.R.C. by W. Ruddell, Recorded in Bk.3 P.952, Found 26mm Bar:

Unrecorded cor. card by MDOT, R. Kent 1960- Found Axle Shaft buried 15cm deep:


Surveys by: Lapham, L. 1, pg. 46, Schafer, L. 2, pg. 127 & 128, Ruddell, L. 4, pg. 592, Fluharty, L. 2, pg. 212, County Survey Book 3, pg. 79

(F-6) Center 1/4 Cor., Sec. 9, T14N-R3W

This position not established by original government survey.

L.C.R.C. by J. Fokens, Recorded in Bk. 4 P. 1190, Found Tee Iron @ CL: S72°W 22.708M N&T N. Face P. Pole; S42°E 16.054M N&T NE'ly Face 20cm Maple; South 10.06M Tee Iron; N35°W 13.768M N&T 15cm Ash.

Survey by Fokens, L. 5, pg. 241 (No County Surveyor records)

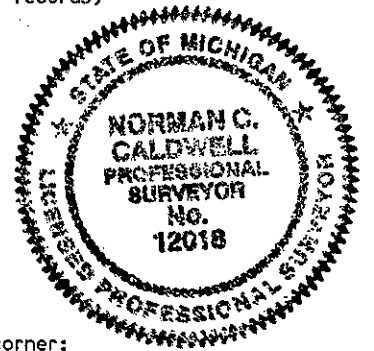

B. Description of corner evidence found and/or method applied in restoring or reestablishing corner:

F-5 1/4 Cor. Sec. 9 & 16, T14N-R3W

Found 26mm Iron Bar per Bk. 1 Pgs. 295, 315, and 369; and Bk.3 P.952.

F-6 Center 1/4 Cor., Sec. 16, T14N-R3W

Found Tee Iron per Book 4 Page 1190.

C. Description of monument for corner and accessories established to perpetuate locating the position of the corner:

F-5 1/4 Cor. Sec.9 & 16, T14N-R3W

Found 26mm Iron Bar per Bk.1 Pgs. 295, 315, and 369; and Bk. 3 P. 952; and is accepted as the best available evidence of the original corner.  
S35°E 8.633M 61cm Maple (R)  
S65°E 16.246M 66cm Maple (R)  
N68°E 6.883M Top CL West end 30.5cm CMP (R)  
N06°W 25.952M Petro. Line Marker (R)

F-6 Center 1/4 Cor., Sec. 16, T14N-R3W

Found Tee Iron per Bk.4 P.1190, and is accepted as a careful and faithful determination of the position of the corner.  
N31°W 13.747M 15cm Ash (R)  
S48°E 16.032M 15cm Maple (R)  
South 10.058M Tee Iron (R)  
S68°W 22.705M P.Pole (R)

Signed by *Norman C. Caldwell*  
Surveyor's Michigan License No. 12018

Date 26 NOV 93