

**LAND CORNER RECORDATION CERTIFICATE**  
**Filing Requirement of Act 74, Mich. P.A. 1970**  
**Isabella County Remonumentation**

JAN 25 2000

For Corners in  
Isabella

(County)	Located In:	Corner Code#:
1. Public Land Survey	T. <u>14N</u> R. <u>3W</u>	<u>G-1</u>
	T. _____ R. _____	_____
	T. _____ R. _____	_____
2. Public Controlling in Section	S. _____ T. _____ R. _____	_____
	S. _____ T. _____ R. _____	_____
3. Miscellaneous Property in Section	S. _____ T. _____ R. _____	_____
	S. _____ T. _____ R. _____	_____
4. Lot No. _____, Recorded Plat _____		
5. Private Claims _____		

199900012545  
 Filed for Record in  
 ISABELLA COUNTY, MI  
 SHARON A BROWN  
 On 12-16-1999 At 08:33:29 am.  
 RE LAND COR 9.00  
 Liber 1 Page 324 - 324

SECTION

Register of Deeds Stamp & File Number


I, Jan S. Fokens, in a field survey on June 2, 1999, do hereby certify that under requirements of P.A. 74, Michigan P.A. of 1970, the corner points mentioned in lines 1 and 2 above were in conformance with regulations and rules therefore as required in the current manual of survey instructions of the United States Department of the Interior, Bureau of Land Management or by a decree of a Court of Law and/or that the corner points mentioned in lines 3, 4 and 5 above were in conformance with the rules of the Michigan Board of Land Surveyors or by a Decree of a Court of Law, established, re-established, monumented, re-monumented, recovered, found as expressed below.

**NOTE: Not more than 2 corners, all in the same town and range, may be recorded on this certificate.**

	A	B	C	D	E	F	G	H	I	J	K	L	M
1													
2	6	5	4	3	2	1							
3													
4	7	8	9	10	11	12							
5													
6	18	17	16	15	14	13							
7													
8	19	20	21	22	23	24							
9													
10	30	29	28	27	26	25							
11													
12	31	32	33	34	35	36							
13													

**A. Description of original monument and accessories and/or subsequent restoration:**

- G.L.O Original Survey:  
 Township: Robert Clark Jr. 2nd Quarter 1831  
 Subdivision: Hiram Burnham 3rd Quarter 1832  
 Pages 88, 86, 116, and 136 original field notes
- County Survey Records:  
 Liber 3, Page 80 James Freeman June 1896 Set W. Oak stake corner 33/34 86 East
- L.C.R.C.:  
 Liber 1, Page 147 A.V. Courtright Recorded date July 16, 1973 Found 2" pipe  
 Liber 3, Page 819 Jan S. Fokens Recorded date November 18, 1986 Found 1" pipe  
 Liber 4, Page 1085 Gerald Gray Recorded date February 1, 1991 Found 2" pipe
- Surveys of Record:  
 None of record
- Unrecorded Survey:  
 Isabella County Road Commission Found 1" pipe Witnesses noted  
 Isabella County Road Commission Found 1 1/2" rod Witnesses noted

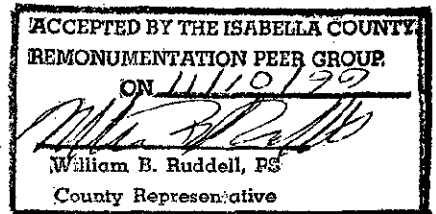

**B. Description of corner evidence found and/or method applied in restoring or re-establishing corner:**

This corner established in Isabella County Remonumentation Program. See dossier for detailed report.  
 This is an existent corner.  
 1. Found 1 1/2" x 1.5' pipe 0.9' below road surface  
 2. Found wood fragments adjacent to found pipe  
 3. Excavated to 4.0'. Found no further evidence.


Accepted as the best available evidence of the position of the original corner and replaced with Standard Monument Corner.

**C. Description of monument for corner and accessories established to perpetuate locating the position of the corner:**

Set Standard Isabella County Monument in Monument Box, stamped G-1 and PS 21567.

**G-1 NW. Corner, Section 3, T.14N.-R.3W., Chippewa Township, Isabella County**  
 S.44°W. 51.84' Set notch top center of corrugated metal pipe  
 S.30°E. 53.74' Set notch in top center of corrugated metal pipe  
 N.21°W. 47.00' Found Ruddell Nail & Cap in east face of fence post  
 East 56.72' (CSR 86 lks=56.76') (G-13) SW 1/4, Sec. 34, T15N-R3W, Denver Twp., Isabella Co., Michigan  
 N.89°54'28"E. 2686.51' (H-1) N.1/4 corner, Section 3, T.14N.-R.3W., Chippewa Twp., Isabella Co., Michigan  
 S.89°53'19"W. 2630.68' (F-1) N.1/4 corner, Section 3, T.14N.-R.3W., Chippewa Twp., Isabella Co., Michigan

Signed by Jan S. Fokens  
 Surveyor's Michigan License No. 21567

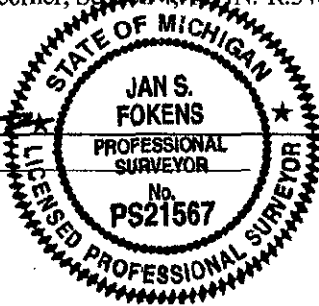

Date 12/14/99