

LAND CORNER RECORDATION CERTIFICATE
Filing Requirement of Act 74, Mich. P.A. 1970
Isabella County Remonumentation

JAN 25 2000

For Corners in
Isabella

(County)	Located In:	Corner Code#:
1. Public Land Survey	T. <u>14N</u> R. <u>3W</u>	<u>H-1</u>
	T. _____ R. _____	_____
	T. _____ R. _____	_____
2. Public Controlling in Section	S. _____ T. _____ R. _____	_____
	S. _____ T. _____ R. _____	_____
3. Miscellaneous Property in Section	S. _____ T. _____ R. _____	_____
	S. _____ T. _____ R. _____	_____
4. Lot No. _____, Recorded Plat _____		
5. Private Claims _____		

199900012546
 Filed for Record in
 ISABELLA COUNTY, MI
 SHARON A BROWN
 On 12-16-1999 At 08:33:33 am.
 RE LAND COR 9.00
 Liber 1 Page 325 - 325

SECTION

Register of Deeds Stamp & File Number


I, Jan S. Fokens, in a field survey on June 10, 1999, do hereby certify that under requirements of P.A. 74, Michigan P.A. of 1970, the corner points mentioned in lines 1 and 2 above were in conformance with regulations and rules therefore as required in the current manual of survey instructions of the United States Department of the Interior, Bureau of Land Management or by a decree of a Court of Law and/or that the corner points mentioned in lines 3, 4 and 5 above were in conformance with the rules of the Michigan Board of Land Surveyors or by a Decree of a Court of Law, established, re-established, monumented, re-monumented, recovered, found as expressed below.

NOTE: Not more than 2 corners, all in the same town and range, may be recorded on this certificate.

1	A	B	C	D	E	F	G	H	I	J	K	L	M
2	6	5	4	3	2	1							
3													
4	7	8	9	10	11	12							
5													
6	18	17	16	15	14	13							
7													
8	19	20	21	22	23	24							
9													
10	30	29	28	27	26	25							
11													
12	31	32	33	34	35	36							
13													

A. Description of original monument and accessories and/or subsequent restoration:

- G.L.O Original Survey:
 Township: Robert Clark Jr. 2nd Quarter 1831
 Pages 86, 88 original field notes
- County Survey Records:
 Liber 3, Page 183 William Trussell June 1902 W. Oak stake.
- L.C.R.C.:
 Liber 1, Page 404 Herbert Fluharty Recorded date January 10, 1977 Set 5/8" x 18" re-rod w/RLS cap equidistant and on line
- Surveys of Record:
 None of record
- Unrecorded Survey:
 None available

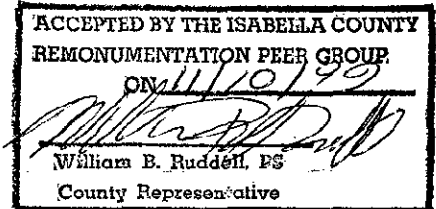

B. Description of corner evidence found and/or method applied in restoring or re-establishing corner:

- This corner established in Isabella County Remonumentation Program. See dossier for detailed report.
 This is an existent corner.
- Found F.E.I. capped iron
 - Excavated to 2.0'. Found no further evidence

Accepted as the best available evidence of the position of the original corner and replaced with Standard Monument Corner.

C. Description of monument for corner and accessories established to perpetuate locating the position of the corner:
 Set Standard Isabella County Monument in Monument Box, stamped H-1 and PS 21567.

H-1 N. 1/4 Corner, Section 3, T.14N.-R.3W., Chippewa Township, Isabella County
 S.69°E. 35.16' Set Nail & LSC cap in north face of mailbox post (#9590)
 N.69°E. 61.09' Found Mid Michigan Nail & Cap in SE face of 8" Ash
 N.51°W. 74.17' Set LSC Nail & Cap in the south face of 24" Spruce
 S.79°W. 32.90' North face of mailbox post (#9571)
 East 25.99' (H-13) S. 1/4, Sec. 34, T15N-R3W, Denver Twp., Isabella Co., Michigan
 N.89°53'49"E. 2686.57' (I-1) NE corner, Section 3, T14N-R.3W, Chippewa Twp., Isabella Co., Michigan
 S.89°54'28"W. 2686.51' (G-1) NE. corner, Section 4, T.14N.-R.3W., Chippewa Twp., Isabella Co., Michigan.

Signed by Jan S. Fokens
 Surveyor's Michigan License No. 21567



Date 12/14/99