

LAND CORNER RECORDATION CERTIFICATE
Filing Requirement of Act 74, Mich. P.A. 1970
Isabella County Remonumentation

JAN 25 2000

For Corners in
Isabella

(County)

Located In:

Corner Code#:

- | | | |
|---------------------------------------|----------------------------|------------|
| 1. Public Land Survey | T. <u>14N</u> R. <u>3W</u> | <u>J-1</u> |
| | T. _____ R. _____ | _____ |
| | T. _____ R. _____ | _____ |
| 2. Public Controlling in Section | S. _____ T. _____ R. _____ | _____ |
| | S. _____ T. _____ R. _____ | _____ |
| 3. Miscellaneous Property in Section | S. _____ T. _____ R. _____ | _____ |
| | S. _____ T. _____ R. _____ | _____ |
| 4. Lot No. _____, Recorded Plat _____ | | |
| 5. Private Claims _____ | | |

199900012548
 Filed for Record in
 ISABELLA COUNTY, MI
 SHARON A BROWN
 On 12-16-1999 At 08:33:39 am.
 RE LAND COR 9.00
 Liber 1 Page 327 - 327

SECTION

Register of Deeds Stamp & File Number

I, Jan S. Fokens, in a field survey on July 13, 1999, do hereby certify that under requirements of P.A. 74, Michigan P.A. of 1970, the corner points mentioned in lines 1 and 2 above were in conformance with regulations and rules therefore as required in the current manual of survey instructions of the United States Department of the Interior, Bureau of Land Management or by a decree of a Court of Law and/or that the corner points mentioned in lines 3, 4 and 5 above were in conformance with the rules of the Michigan Board of Land Surveyors or by a Decree of a Court of Law, established, re-established, monumented, re-monumented, recovered, found as expressed below.

NOTE: Not more than 2 corners, all in the same town and range, may be recorded on this certificate.

1	A	B	C	D	E	F	G	H	I	J	K	L	M
2	6	5	4	3	2	1							
3													
4	7	8	9	10	11	12							
5													
6	18	17	16	15	14	13							
7													
8	19	20	21	22	23	24							
9													
10	30	29	28	27	26	25							
11													
12	31	32	33	34	35	36							
13													

A. Description of original monument and accessories and/or subsequent restoration:

1. G.L.O Original Survey:

Township: Robert Clark Jr. 2nd Quarter 1831
 Pages 84, 88 original field notes

2. County Survey Records:

None of record

3. L.C.R.C.:


Liber 3, page 779 Jerry Wilcox Recorded date November 15, 1985 Set capped iron at S.P. position
 Liber 4, Page 1104 Gerald Gray Recorded date August 7, 1991 Found 1/2" capped rod

4. Surveys of Record:

None of record

5. Unrecorded Survey:

Mid-Michigan Engineering 4/10/91 Certificate of Survey Found 1/2" capped rod 8' south of road centerline and on extension of fence to south

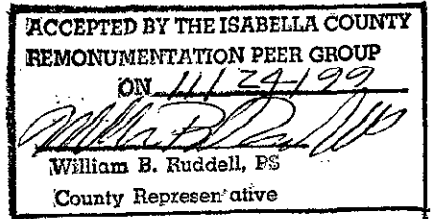

B. Description of corner evidence found and/or method applied in restoring or re-establishing corner:

This corner established in Isabella County Remonumentation Program. See dossier for detailed report.
 This is an existent corner.

1. Found re-rod bent to the North 8' south of centerline of Baseline road
2. Excavated 2.5'. Found no further evidence


Accepted as the best available evidence of the position of the accepted corner and replaced with Standard Monument Corner.

C. Description of monument for corner and accessories established to perpetuate locating the position of the corner:

Set Standard Isabella County Monument in Monument Box, stamped J-1 and PS 21567.

- J-1 N. 1/4 Corner, Section 2, T.14N.-R.3W., Chippewa Township, Isabella County**
- N.58°E. 54.56' Top center of telephone riser
 - N.43°W. 39.12' Found nail & flagging in E. face of 38" double Poplar tree
 - S.50°E. 23.64' Chiseled an "+" at end of 18" cmp
 - N.31°E. 62.81' Found nail & tag in E. face of power pole
 - East 26.35' (J-13) S. 1/4 Corner, Section 32, T.15N.-R.3W., Denver Township., Isabella County., MI.
 - S.89°57'58"E. 2626.68' (K-1) Remonumented corner, NE. Corner, Section 2, T.14N.-R.3W., Chippewa Township, Isabella County, MI
 - S.89°59'47"W. 2626.75' (I-1) Remonumented Corner NE. Corner, Section 2, T.14N.-R.3W., Chippewa Twp., Isabella Co., MI

Signed by _____
 Surveyor's Michigan License No. 21567

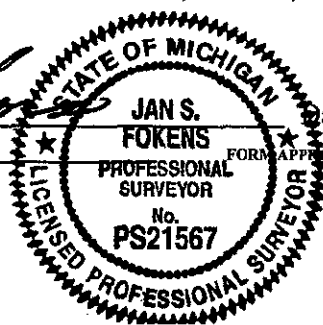

Date 12/14/99

FORM APPROVED BY MICHIGAN STATE BOARD OF LAND SURVEYORS, JAN.28, 1971
 REVISED MAY 14, 1975
 REVISED JAN., 1983