

00078

MAR 09 1999

LAND CORNER RECORDATION CERTIFICATE
Filing Requirement of Act 74, Mich. P.A. 1970
Isabella County Remonumentation

SECTION

For Corners in
Isabella

(County)	Located In:	Corner Code#:
1. Public Land Survey	T. <u>14N</u> R. <u>3W</u>	<u>K-6</u> ✓
	T. <u>14N</u> R. <u>3W</u>	<u>K-7</u>
	T. _____ R. _____	_____
2. Public Controlling in Section	S. _____ T. _____ R. _____	_____
	S. _____ T. _____ R. _____	_____
3. Miscellaneous Property in Section	S. _____ T. _____ R. _____	_____
	S. _____ T. _____ R. _____	_____
4. Lot No. _____, Recorded Plat _____		
5. Private Claims _____		

9900000078
Filed for Record in
ISABELLA COUNTY, MI
SHARON A BROWN
On 01-05-1999 At 09:29:36 am.
RE LAND COR 9.00
Liber 1 Page 267 - 267

Register of Deeds Stamp & File Number

I, Jan S. Fokens, in a field survey on December 21, 1998, do hereby certify that under requirements of P.A. 74, Michigan P.A. of 1970, the corner points mentioned in lines 1 and 2 above were in conformance with regulations and rules therefore as required in the current manual of survey instructions of the United States Department of the Interior, Bureau of Land Management or by a decree of a Court of Law and/or that the corner points mentioned in lines 3, 4 and 5 above were in conformance with the rules of the Michigan Board of Land Surveyors or by a Decree of a Court of Law, established, re-established, monumented, re-monumented, recovered, found as expressed below.

NOTE: Not more than 2 corners, all in the same town and range, may be recorded on this certificate.

A. Description of original monument and accessories and/or subsequent restoration:

Approved and Recorded Isabella County Remonumentation
L.C.R.C. approved 11/23/98, Recorded Liber 1, Page 17 (K-6) and Page 18 (K-7)
Dossier on file at Isabella County Register of Deeds
verified position and material from Remonumentation dossier and L.C.R.C.

B. Description of corner evidence found and/or method applied in restoring or re-establishing corner:

K-6 Found T-iron in monument box
K-7 Found T-iron in monument box

Accepted as the best available evidence of the position of the original corner and replaced with Standard Monument Corner.


Description of monument for corner and accessories established to perpetuate locating the position of the corner:
Set Standard Isabella County Monument in Monument Box stamped K-6, K-7 and PS 21567.

K-6
S.52°W. 44.17' Set LSC nail and tag in S. face of 8" Poplar tree
N.88°E 48.62' Set LSC nail and tag in N. face of 5" White pine
S.29°E. 65.28' Set LSC nail and tag in S. face of 3" pine
N.13°W. 111.84' Found nail in E. face of 14" White pine

K-7
N.48°E. 44.55' Found Nail and tag #20705 in N. face of 14" White pine
N.45°W. 65.86' Found nail in 12" twin Maple tree
S.54°W. 46.38' Found nail in power pole
S.37°E. 47.15' Set LSC nail and tag in S. face of 7" Elm tree

ACCEPTED BY THE ISABELLA COUNTY
REMONUMENTATION PEER GROUP
ON Nov. 23, 1998
William B. Ruddell
William B. Ruddell, F.S.
County Representative

Signed by Jan S. Fokens
Surveyor's Michigan License No. 21567

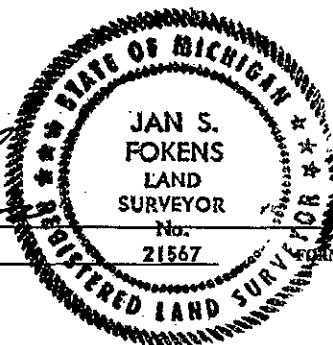

Date Dec. 30, 1998