

LAND CORNER RECORDATION CERTIFICATE
Filing Requirement of Act 74, Mich. P.A. 1970
Isabella County Remonumentation

JAN 25 2000

For Corners in
Isabella

(County)	Located In:	Corner Code#:
1. Public Land Survey	T. <u>14N</u> R. <u>3W</u>	<u>L-1</u>
	T. _____ R. _____	_____
	T. _____ R. _____	_____
2. Public Controlling in Section	S. _____ T. _____ R. _____	_____
	S. _____ T. _____ R. _____	_____
3. Miscellaneous Property in Section	S. _____ T. _____ R. _____	_____
	S. _____ T. _____ R. _____	_____
4. Lot No. _____, Recorded Plat _____		
5. Private Claims _____		

SECTION

199900012549
 Filed for Record in
 ISABELLA COUNTY, MI
 SHARON A BROWN
 On 12-16-1999 At 08:34:54 am.
 RE LAND COR 9.00
 Liber 1 Page 328 - 328

Register of Deeds Stamp & File Number

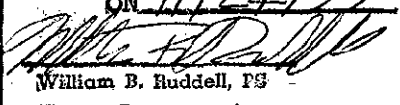
I, Jan S. Fokens, in a field survey on October 10, 1999, do hereby certify that under requirements of P.A. 74, Michigan P.A. of 1970, the corner points mentioned in lines 1 and 2 above were in conformance with regulations and rules therefore as required in the current manual of survey instructions of the United States Department of the Interior, Bureau of Land Management or by a decree of a Court of Law and/or that the corner points mentioned in lines 3, 4 and 5 above were in conformance with the rules of the Michigan Board of Land Surveyors or by a Decree of a Court of Law, established, re-established, monumented, re-monumented, recovered, found as expressed below.

NOTE: Not more than 2 corners, all in the same town and range, may be recorded on this certificate.

1	A	B	C	D	E	F	G	H	I	J	K	L	M
2	6	5	4	3	2	1							
3													
4	7	8	9	10	11	12							
5													
6	18	17	16	15	14	13							
7													
8	19	20	21	22	23	24							
9													
10	30	29	28	27	26	25							
11													
12	31	32	33	34	35	36							
13													

A. Description of original monument and accessories and/or subsequent restoration:

- G.L.O Original Survey:
 Township: Robert Clark Jr. 2nd Quarter 1831
 Pages 84, 88 original field notes
- County Survey Records:
 Liber 2, Page 144 J. Freeman October 1921 Set pine stake equidistant and on line
 Liber 3, Page 147 E.R. Coburn August 1899 stake at corner
- L.C.R.C.:
 Liber 4, Page 1294 Gerald Gray Recorded date March 15, 1995 Set bar and cap on line halfway according to CSR.
- Surveys of Record:
 None of Record
- Unrecorded Survey:
 None Available

**ACCEPTED BY THE ISABELLA COUNTY
 REMONUMENTATION PEER GROUP**
 ON 11/24/99

 William B. Huddell, PS
 County Representative

B. Description of corner evidence found and/or method applied in restoring or re-establishing corner:

This corner established in Isabella County Remonumentation Program. See dossier for detailed report.
 This is an existent corner.

- Found capped iron
- Excavated to 3.5'. Found no further evidence.
- Set corner 1.18' South of found point on line between K-1 and M-1/M-13 according to the original G.L.O.
- Excavated to 2.5'. Found no evidence of corner.

Accepted as the best available evidence of the position of the accepted corner and replaced with Standard Monument Corner.

C. Description of monument for corner and accessories established to perpetuate locating the position of the corner:

Set Standard Isabella County Monument in Monument Box, stamped L-1 and PS 21567.

- L-1 N. 1/4 Corner, Section 1, T.14N.-R.3W., Chippewa Township, Isabella County**
- N.72°E. 16.42' Found nail and cap in S. face of 4" Poplar tree
 - East 14.79' (L-13) S. 1/4 Corner, Section 36, T.15N.-R.3W., Denver Twp., Isabella Co., MI.
 - S.43°E. 10.19' Found nail and cap in SW. face of 2" Oak tree
 - S.74°W. 12.52' Found nail and cap in N. face of 5" Oak tree
 - N.53°W. 5.56' Found nail and cap in SW. face of 6" Oak tree
 - N.89°48'20"E. 2655.59' (M-1/M-13) Remonumented Corner NE. Corner, Section 1, T.14N.-R.3W., Chippewa Twp., Isabella Co.
 SE Corner, Section 36, T.15N.-R.3W., Denver Twp., Isabella Co., MI.
 - S.89°48'20"W. 2655.59' (K-1) NW Corner, Section 1, T.14N.-R.3W., Chippewa Township, Isabella County, MI

Signed by Jan S. Fokens
 Surveyor's Michigan License No. 21567



12/14/99