

00080

SURVEY & REMONUMENTATION

LAND CORNER RECORDATION CERTIFICATE

Filing Requirement of Act 74, Mich. P.A. 1970

MAR 09 1999

Isabella County Remonumentation

SECTION

For Corners in Isabella

(County)

Located In:

Corner Code#:

- 1. Public Land Survey T. 14N R. 3W M-4 M-6
2. Public Controlling in Section S. T. R.
3. Miscellaneous Property in Section S. T. R.
4. Lot No. Recorded Plat
5. Private Claims

9900000080 Filed for Record in ISABELLA COUNTY, MI SHARON A BROWN On 01-05-1999 At 09:29:48 am. RE LAND COR 9.00 Liber 1 Page 269 - 269

Register of Deeds Stamp & File Number

I, Jan S. Fokens, in a field survey on December 21, 1998, do hereby certify that under requirements of P.A. 74, Michigan P.A. of 1970, the corner points mentioned in lines 1 and 2 above were in conformance with regulations and rules therefore as required in the current manual of survey instructions of the United States Department of the Interior, Bureau of Land Management or by a decree of a Court of Law and/or that the corner points mentioned in lines 3, 4 and 5 above were in conformance with the rules of the Michigan Board of Land Surveyors or by a Decree of a Court of Law, established, re-established, monumented, re-monumented, recovered, found as expressed below.

Grid table with columns A-M and rows 1-13. Contains numbers 1-36 and some dots.

NOTE: Not more than 2 corners, all in the same town and range, may be recorded on this certificate.

A. Description of original monument and accessories and/or subsequent restoration:

Approved and Recorded Isabella County Remonumentation L.C.R.C. approved 11/23/98, Recorded Liber 1, Page 20 (M-4) and Page 21 (M-6) Dossier on file at Isabella County Register of Deeds verified position and material from Remonumentation dossier and L.C.R.C.

B. Description of corner evidence found and/or method applied in restoring or re-establishing corner:

- M-4 Found capped iron
M-6 Found 1 3/4" pipe in monument box


Accepted as the best available evidence of the position of the original corner and replaced with Standard Monument Corner.

Description of monument for corner and accessories established to perpetuate locating the position of the corner: Set Standard Isabella County Monument in Monument Box stamped M-4, M-6 and PS 21567.

- M-4 N.10°E. 78.14' 33" Maple clump
S.33°W. 21.58' 31" Maple quad
North 92.78' A-4, W. 1/4 Corner, Section 7, T.14N.-R.2W., Greendale Township, Midland Co.
S.42°E. 40.90' Found nail in 20" White Oak tree
S.47°W. 119.50' Power pole

- M-6 N.50°E. 48.64' 6" Maple
N.70°W. 79.86' 12" Maple
S.55°W. 83.28' 10" twin Maple
S.70°E. 59.31' 4" White Pine
N.75°E. 42.28' 6" Maple
North 70.37' 1/2" iron rod

ACCEPTED BY THE ISABELLA COUNTY REMONUMENTATION PEER GROUP ON Nov. 23, 1998 William B. Ruddell, PS County Representative

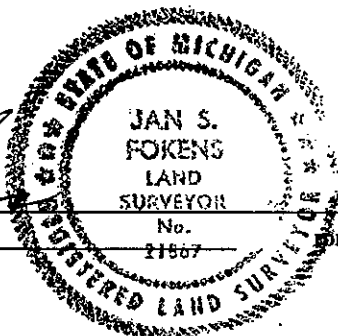

Signed by Jan S. Fokens Surveyor's Michigan License No. 21567

Date Dec. 30, 1998