

001.11

LAND CORNER RECORDATION CERTIFICATE
Filing Requirement of Act 74, Mich. P.A. 1970
Isabella County Remonumentation

000214

For Corners in
Isabella

(County)

Located In:

Corner Code#:

Public Land Survey

T. 14N R. 3W

G-6, H-7

T. R.

T. R.

Seg #2

Public Controlling
in Section

S. T. R.

S. T. R.

Miscellaneous
Property in Section

S. T. R.

S. T. R.

Lot No. Recorded Plat

Private Claims

9800000141
Filed for Record in
ISABELLA COUNTY, MI
SHARON A BROWN
On 01-06-1998 At 11:17:28 am.
RE LAND COR 9.00
Book DR Vol. 1 Pg. 214 - 214

Register of Deeds Stamp & File Number

Jan S. Fokens, in a field survey on December 22, 1997, do hereby certify that under requirements of
Act 74, Michigan P.A. of 1970, the corner points mentioned in lines 1 and 2 above were in conformance
with regulations and rules therefore as required in the current manual of survey instructions of the United
States Department of the Interior, Bureau of Land Management or by a decree of a Court of Law and/or
that the corner points mentioned in lines 3, 4 and 5 above were in conformance with the rules of the
Michigan Board of Land Surveyors or by a Decree of a Court of Law, established, re-established,
monumented, re-monumented, recovered, found as expressed below.

NOTE: Not more than 2 corners, all in the same town and range, may be
recorded on this certificate.

A. Description of original monument and accessories and/or subsequent
restoration:

Approved and Recorded Isabella County Remonumentation
L.C.R.C. approved November 11, 1993, Liber 1, Page 11 (G-6), Page 12 (H-7)
Dossier on file at Isabella County Register of Deed

B. Description of corner evidence found and/or method applied in restoring or re-establishing corner:

This corner established in Isabella County Remonumentation Program. See dossier for detailed report.
G-6 Found 5/8" rod in Monument Box
H-7 Found 1.5" pipe with re-rod inside in Monument Box
Verified position and material from Remonumentation dossier & L.C.R.C. (This corner has been disturbed for road construction).

C. Description of monument for corner and accessories established to perpetuate locating the position of the corner:

Set Standard Isabella County Monument in Monument Box, marked L.S.C. # 21567 & G-6, H-7.

G-6 H-7
S.53°W. 57.51' REI tag in 25" White Oak S.4°E. 60.02' 7.5" Walnut
S.43°W. 88.75' REI tag in 10" Black Oak S.60°W. 80.24' 24" Willow
N.60°E. 58.02' North face of 12" Red Pine N.32°E. 38.32' REI tag in 6" Scotch Pine
N.65°E. 36.20' South face of p.p. S.45°E. 51.95' Nail & flag in 5" Red Pine



SURVEY &
REMONUMENTATION

MAR 09 1998

SECTION

ACCEPTED BY THE ISABELLA COUNTY
REMONUMENTATION PEER GROUP
ON 11/23/93
William B. Ruddell, Esq
County Representative

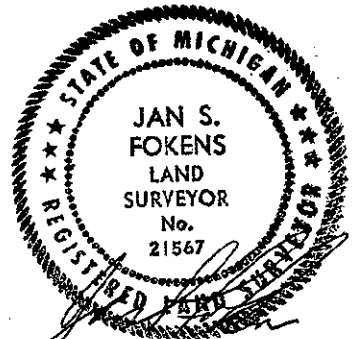

Signed by Jan S. Fokens
Surveyor's Michigan License No. 21567

Date OCT. 26, 1997