

MAR 09 1998

00139

LAND CORNER RECORDATION CERTIFICATE  
Filing Requirement of Act 74, Mich. P.A. 1970  
Isabella County Remonumentation

SECTION

000212

For Corners in  
Isabella

(County)

Located In: Corner Code#:

- 1. Public Land Survey T. 14N R. 3W C-6, D-6  
T. \_\_\_\_\_ R. \_\_\_\_\_  
T. \_\_\_\_\_ R. \_\_\_\_\_ Seg. #2
- 2. Public Controlling S. \_\_\_\_\_ T. \_\_\_\_\_ R. \_\_\_\_\_  
in Section S. \_\_\_\_\_ T. \_\_\_\_\_ R. \_\_\_\_\_
- 3. Miscellaneous S. \_\_\_\_\_ T. \_\_\_\_\_ R. \_\_\_\_\_  
Property in Section S. \_\_\_\_\_ T. \_\_\_\_\_ R. \_\_\_\_\_
- 4. Lot No. \_\_\_\_\_, Recorded Plat \_\_\_\_\_
- 5. Private Claims \_\_\_\_\_

9800000139  
Filed for Record in  
ISABELLA COUNTY, MI  
SHARON A BROWN  
On 01-06-1998 At 11:17:18 am.  
RE LAND COR 9.00  
Book OR Vol. 1 Pg. 212 - 212

Register of Deeds Stamp & File Number

I, Jan S. Fokens, in a field survey on December 22, 1997, do hereby certify that under requirements of P.A. 74, Michigan P.A. of 1970, the corner points mentioned in lines 1 and 2 above were in conformance with regulations and rules therefore as required in the current manual of survey instructions of the United States Department of the Interior, Bureau of Land Management or by a decree of a Court of Law and/or that the corner points mentioned in lines 3, 4 and 5 above were in conformance with the rules of the Michigan Board of Land Surveyors or by a Decree of a Court of Law, established, re-established, monumented, re-monumented, recovered, found as expressed below.

NOTE: Not more than 2 corners, all in the same town and range, may be recorded on this certificate.

|    | A  | B  | C  | D  | E  | F  | G | H | I | J | K | L | M |
|----|----|----|----|----|----|----|---|---|---|---|---|---|---|
| 1  |    |    |    |    |    |    |   |   |   |   |   |   |   |
| 2  | 6  | 5  | 4  | 3  | 2  | 1  |   |   |   |   |   |   |   |
| 3  |    |    |    |    |    |    |   |   |   |   |   |   |   |
| 4  | 7  | 8  | 9  | 10 | 11 | 12 |   |   |   |   |   |   |   |
| 5  |    |    |    |    |    |    |   |   |   |   |   |   |   |
| 6  | 18 | 17 | 16 | 15 | 14 | 13 |   |   |   |   |   |   |   |
| 7  |    |    |    |    |    |    |   |   |   |   |   |   |   |
| 8  | 19 | 20 | 21 | 22 | 23 | 24 |   |   |   |   |   |   |   |
| 9  |    |    |    |    |    |    |   |   |   |   |   |   |   |
| 10 | 30 | 29 | 28 | 27 | 26 | 25 |   |   |   |   |   |   |   |
| 11 |    |    |    |    |    |    |   |   |   |   |   |   |   |
| 12 | 31 | 32 | 33 | 34 | 35 | 36 |   |   |   |   |   |   |   |
| 13 |    |    |    |    |    |    |   |   |   |   |   |   |   |

A. Description of original monument and accessories and/or subsequent restoration:

Approved and Recorded Isabella County Remonumentation  
Corner approved November 11, 1993, Recorded Liber 1, Page 5 (C-6), Page 6 (D-6)  
Dossier on file at Isabella County Register of Deed

B. Description of corner evidence found and/or method applied in restoring or re-establishing corner:

This corner established in Isabella County Remonumentation Program.  
C-6 Found a 3/4" iron pin in center of 1 1/4" pipe, 36" length in Monument Box  
D-6 Found rod in Monument Box


Verified position and material from Remonumentation dossier & L.C.R.C. (This corner has been disturbed for road construction).

C. Description of monument for corner and accessories established to perpetuate locating the position of the corner:

Set Standard Isabella County Monument in Monument Box, marked LSC #21567 & C-6, D-6

- |                |  |                 |                                   |
|----------------|--|-----------------|-----------------------------------|
| C-6            |  | D-6             |                                   |
| N.30°W. 74.15' | Set LSC nail and tag in East face trans. pole                                  | N.16°E. 38.31'  | REI tag in 24" Maple              |
| N.62°E. 73.50' | Top end set bolt in pedestrian pole  | S.7°W. 33.03'   | REI tag in telephone pole         |
| S.40°E. 62.20' | Set LSC nail and tag in SW. face drop pole                                     | S.8°W. 55.88'   | REI tag in power pole             |
| S.45°W. 62.98' | Found pk nail and tag in SE. face buckarm trans. pole (previous witness point) | N.68°W. 111.26' | Nail & Flag in power service pole |

ACCEPTED BY THE ISABELLA COUNTY  
REMONUMENTATION PEER GROUP  
ON 11/23/93  
*William B. Raddell*  
William B. Raddell, Esq.  
County Representative

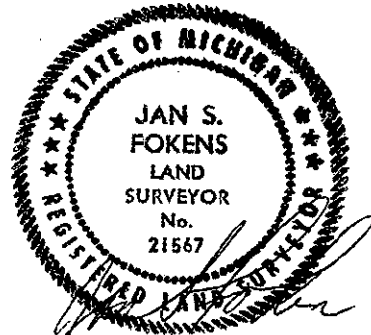

Signed by *Jan S. Fokens*  
Surveyor's Michigan License No. 21567

Date Dec 30, 1997