

001.10

LAND CORNER RECORDATION CERTIFICATE
Filing Requirement of Act 74, Mich. P.A. 1970
Isabella County Remonumentation

000213

For Corners in
Isabella

(County) Located In: Corner Code#:
1. Public Land Survey T. 14N R. 3W E-6, F-6
2. Public Controlling in Section S. T. R.
3. Miscellaneous Property in Section S. T. R.
4. Lot No. Recorded Plat
5. Private Claims

9800000140
Filed for Record in
ISABELLA COUNTY, MI
SHARON A BROWN
On 01-06-1998 At 9:00:17:24 am.
RE: LAND COR
Book OR Vol. 1 Pg. 213 - 213

Register of Deeds Stamp & File Number

Table with 13 rows and 13 columns (A-M) containing numbers 1-36.

Jan S. Fokens, in a field survey on December 22, 1997, do hereby certify that under requirements of Act 74, Michigan P.A. of 1970, the corner points mentioned in lines 1 and 2 above were in conformance with regulations and rules therefore as required in the current manual of survey instructions of the United States Department of the Interior, Bureau of Land Management or by a decree of a Court of Law and/or that the corner points mentioned in lines 3, 4 and 5 above were in conformance with the rules of the Michigan Board of Land Surveyors or by a Decree of a Court of Law, established, re-established, monumented, re-monumented, recovered, found as expressed below.

NOTE: Not more than 2 corners, all in the same town and range, may be recorded on this certificate.

Description of original monument and accessories and/or subsequent restoration:

Approved and Recorded Isabella County Remonumentation
L.C.R.C. approved November 11, 1993, Recorded Liber 1, Page 8(E-6), Page 9 (F-6)
Dossier on file at Isabella County Register of Deed

Description of corner evidence found and/or method applied in restoring or re-establishing corner:

This corner established in Isabella County Remonumentation Program. See dossier for detailed report.
E-6 Found 1/2" pipe in Monument Box
F-6 Found T-iron in Monument Box
Verified position and material from Remonumentation dossier & L.C.R.C. (This corner has been disturbed for road construction).


Description of monument for corner and accessories established to perpetuate locating the position of the corner:
Set Standard Isabella County Monument in Monument Box, marked LSC # 21567 & E-6, F-6.

E-6 S.40°E. 45.65' T/C of GTE Riser
S.48°E. 56.36' Nail & REI tag in p.p.
S.42°W. 58.91' Nail & flag in p.p.
N.52°W. 78.41' Nail & REI tag in 10" Cottonwood
F-6 N.31°W. 45.10' nail in 6" Ash
S.48°E. 52.59' nail & REI tag in 6" Maple
South 32.99' T-iron
S.68°W. 74.49' R.R. spike in p.p.

SURVEY &
REMONUMENTATION

MAR 09 1998

SECTION

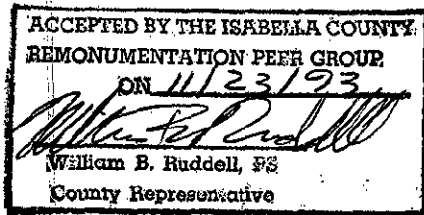

Signed by [Signature]
Surveyor's Michigan License No. 21567

Date Dec. 26, 1997