

00112

LAND CORNER RECORDATION CERTIFICATE
Filing Requirement of Act 74, Mich. P.A. 1970
Isabella County Remonumentation

000215

For Corners in
Isabella

(County)

Located In:

Corner Code#:

- 1. Public Land Survey T. 14N R. 4W M-6
2. Public Controlling in Section S. T. R. Seg #2
3. Miscellaneous S. T. R.
4. Lot No. Recorded Plat
5. Private Claims

9800000142
Filed for Record in
ISABELLA COUNTY, MI
SHARON A BROWN
On 01-06-1998 At 11:17:37 am.
RE LAND COR 9.00
Book OR Vol. 1 Pg. 215 - 215

Register of Deeds Stamp & File Number

I, Jan S. Fokens, in a field survey on December 22, 1997, do hereby certify that under requirements of P.A. 74, Michigan P.A. of 1970, the corner points mentioned in lines 1 and 2 above were in conformance with regulations and rules therefore as required in the current manual of survey instructions of the United States Department of the Interior, Bureau of Land Management or by a decree of a Court of Law and/or that the corner points mentioned in lines 3, 4 and 5 above were in conformance with the rules of the Michigan Board of Land Surveyors or by a Decree of a Court of Law, established, re-established, monumented, re-monumented, recovered, found as expressed below.

NOTE: Not more than 2 corners, all in the same town and range, may be recorded on this certificate.

Grid with columns A-M and rows 1-13. Cell (6,13) contains a dot.

A. Description of original monument and accessories and/or subsequent restoration:

Approved and Recorded Isabella County Remonumentation
L.C.R.C. approved November 11, 1993, Liber 1, Page 26
Dossier on file at Isabella County Register of Deed

B. Description of corner evidence found and/or method applied in restoring or re-establishing corner:

This corner established in Isabella County Remonumentation Program. See dossier for detailed report.
M-6 Found rod in Monument Box
Verified position and material from Remonumentation dossier & L.C.R.C. (This corner has been disturbed for road construction).

C. Description of monument for corner and accessories established to perpetuate locating the position of the corner:

Set Standard Isabella County Monument in Monument Box, marked L.S.C. # 21567 & M-6


- M-6
S.89°E. 66.76' Nail & Disc in 6" Triple Birch
S.37°W. 89.52' REI tag in 16" Honey Locust
North 76.35 W.1/4 Corner, Section 18, T.14N.-R.3W.
S.47°W. 62.86' Nail & flag in p.p.

SURVEY &
REMONUMENTATION

MAR 09 1998

SECTION

ACCEPTED BY THE ISABELLA COUNTY
REMONUMENTATION PEER GROUP
ON 11/23/93
William B. Ruddell, ES.
County Representative

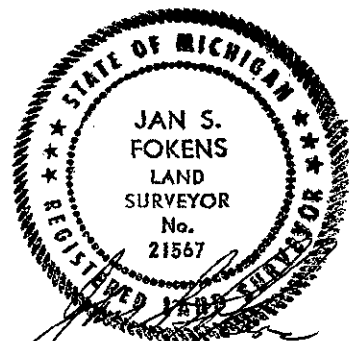

Signed by [Signature]
Surveyor's Michigan License No. 21567

Date 001.26.1998