

**SURVEY &  
REMONUMENTATION**

APR 27 1995

**COMMISSIONER  
REMONUMENTATION CORNER  
LAND CORNER RECORDATION CERTIFICATE  
Filing Requirement of Act 74, Mich. P.A. 1970**

98551

STATE OF MICHIGAN  
COUNTY OF ISABELLA  
REGISTER OF DEEDS

For corners in

ISABELLA  
(County)

Located In:

Corner Code #

- |                                       |                          |            |
|---------------------------------------|--------------------------|------------|
| 1. Public Land Survey                 | T <u>14N</u> R <u>4W</u> | <u>M-7</u> |
|                                       | T _____ R _____          | _____      |
|                                       | T _____ R _____          | _____      |
|                                       | T _____ R _____          | _____      |
| 2. Property Controlling in Section    | S _____ T _____ R _____  | _____      |
|                                       | S _____ T _____ R _____  | _____      |
| 3. Miscellaneous Property in Sec.     | S _____ T _____ R _____  | _____      |
|                                       | S _____ T _____ R _____  | _____      |
| 4. Lot No. _____, Recorded Plat _____ |                          |            |
| 5. Private Claims _____               |                          |            |

MAR 13 2 21 PM '95  
**000059**  
SHARON A. BROWN  
REGISTER OF DEEDS

Register of Deeds Stamp & File Number

I, Wm. B. Ruddell, in a field survey on December, 19 94

do hereby certify that under requirements of P.A. 74, Michigan P.A. of 1970, the corner points mentioned in lines 1 and 2 above were in conformance with regulations and rules therefore as required in the current manual of survey instructions of the United States Department of the Interior, Bureau of Land Management or by a decree of a Court of Law and/or that the corner points mentioned in lines 3, 4 and 5 above were in conformance with the rules of the Michigan Board of Land Surveyors or by a Decree of a Court of Law; established, re-established, monumented, re-monumented, recovered, found as expressed below:

**NOTE: Not more than 4 corners, all in the same town and range, may be recorded on this certificate.**

A	B	C	D	E	F	G	H	I	J	K	L	M
2	6	5	4	3	2	1						
3												
4	7	8	9	10	11	12						
5												
6	18	17	16	15	14	13						
7												
8	19	20	21	22	23	24						
9												
10	30	29	28	27	26	25						
11												
12	31	32	33	34	35	36						
13												

A. Description of original monument and accessories and/or subsequent restoration:

- 1837 - Set Post
- 1838 - Found Post
- 1978 - Found 3/4" Pipe - LCRC 513
- 1989 - Found 1 1/4" Pipe deep raised with "T" Iron - LCRC 978
- 1994 - Found capped "T" iron in mon box
  
- 1968 - Found
- 1993 - Found Capped "T" Iron - LCRC 1241

B. Description of corner evidence found and/or method applied in restoring or reestablishing corner:

- 1994 - Found "T" iron drove in top of 1 1/4" pipe - removed both and augered down to depth of 4' ± - Found no other evidence.


Distance between corners - A-7 T14N-R3W to M-7 T14N-R4W  
 Original Survey - South, 134 links = 88.44 feet  
 Survey, 1910 - South, 99 links = 65.34 feet  
 Survey, 1994 - South, 61.67 feet

And is accepted as a careful and faithful perpetuation of the position of the original corner.

C. Description of monument for corner and accessories established to perpetuate locating the position of the corner:


- 1994 Replaced "T" in existing monument box with standard monument marked M-7

Witnesses: N, 61.76', SW cor. Sec. 18, T14N-R3W  
 NW, 38.55', Chiseled "x" N. End 24" CMP  
 SE, 33.27', Chiseled "x" on 18" CMP + 3' from E. End  
 SW, 31.18', Chiseled "x" on 18" CMP + from W. End

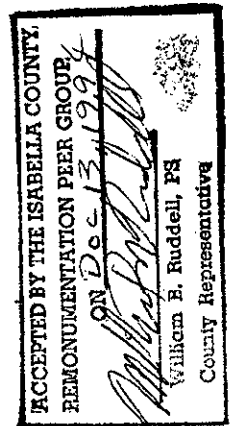

Signed by *William B. Ruddell*  
 Surveyor's Michigan License No. 14769

Date March 13, 1995

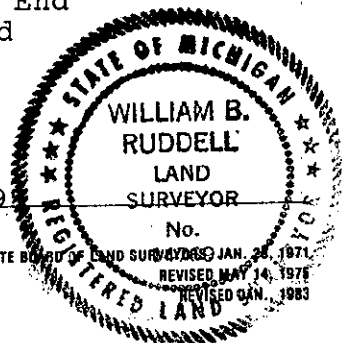

FORM APPROVED BY MICHIGAN STATE BOARD OF LAND SURVEYORS JAN. 23, 1971  
 REVISED MAY 14, 1976  
 REVISED JAN. 1983